

NE SHOBA

L 2002

7/14/79

MISSISSIPPI BOARD OF WATER COMMISSIONERS  
416 North State Street  
Jackson, Mississippi 39201

3

WATER WELL DRILLERS LOG

7-14 1979 Beck Smith Neshoba  
date well completed firm name county well located

LANDOWNER:	description of formations encountered	from	to
Adell Jenkins Phila, Miss (mailing address)			

WELL LOCATION:  
sec. 2 T. 10 N. R. 13 E  
5 1/2 miles E of Phila  
(distance) (direction) (nearest town)

WELL PURPOSE: home  
(home, irrigation, municipal, industrial)

- WELL COMPLETION DATA:
- (1) diameter (inches) 2"
  - (2) total depth (feet) 130'
  - (3) static water level (feet) 60 below top of ground.
  - (4) casing PVC 120' (material) (depth)  
2" (size) if telescope see back.
  - (5) screen 10' 120' (length) (depth to top)  
008 (size) PVC (material)
  - (6) pump 1 HP 7 (HP) (yield gpm)  
elec (type power)
  - (7) electric log no (yes or no)
  - (8) how well bottom plugged

Miss. Board of Water Com.


AUG 16 1979

RECEIVED

DRILLERS REMARKS:

If well telescopes please  
sketch and show depths.

GROUND LEVEL

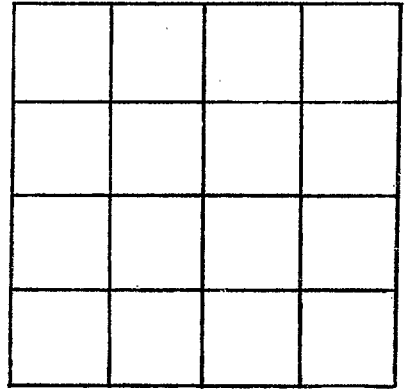

SECTION \_\_\_\_\_

Please indicate well location X.

ADDITIONAL INFORMATION

If more than one screen,  
show locations of each on sketch.