

MISSISSIPPI DEPARTMENT OF NATURAL RESOURCES

Bureau of Land and Water Resources

Southport Mall

P.O. Box 10631

Jackson, Mississippi 39209

WATER WELL DRILLERS LOG

Neshoba
L 2004

9-19-87 1987 Smith's well Phillip Neshoba
 date well completed firm name county well located

LANDOWNER: Smith's Dairy

description of formations encountered

from to

Red clay	0	18
Red sand	18	37
Blue clay	37	120
sand	120	180

(mailing address)

WELL LOCATION:

sec. 1 T. 10 (N) R. 12 (E)
10 miles South of Phila
 (distance) (direction) (nearest town)

WELL PURPOSE:

(home, irrigation, municipal, industrial)

WELL COMPLETION DATA:

- (1) diameter (inches) 4"
- (2) total depth (feet) 180
- (3) static water level (feet) 20 below top of ground.
- (4) casing PVC 170
 (material) (depth)
 (size) if telescope see back.
- (5) screen 10 170
 (length) (depth to top)
4" PVC
 (size) (material)
- (6) pump 3 45
 (HP) (yield gpm)
E
 (type power)
- (7) electric log (yes or no)

(organization running log)

(8) how well bottom plugged CAP

DRILLERS REMARKS:


RECEIVED

SEP 23 1987

Department of Natural Resources
 Bureau of Land & Water Resources

If well telescopes please
sketch and show depths.

GROUND LEVEL

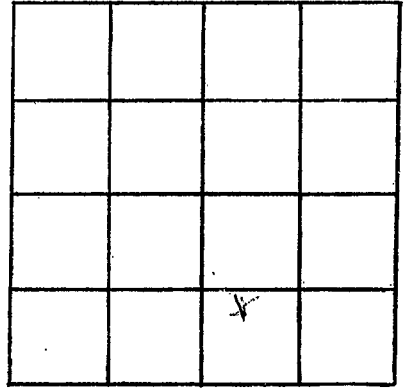

SECTION 1

Please indicate well location X.

ADDITIONAL INFORMATION

If more than one screen,
show locations of each on sketch.