

MISSISSIPPI DEPARTMENT OF NATURAL RESOURCES

Bureau of Land and Water Resources

Southport Mall

P.O. Box 10631

Jackson, Mississippi 39209

WATER WELL DRILLERS LOG

NE3403A  
L 2005

3 27 19 89 Smith's Well Drilling  
date well completed firm name county well located

LANDOWNER: Smith's Dairy

description of formations encountered

from to

Red clay	0	10
Blue clay	10	135
SAND	135	180

(mailing address)

WELL LOCATION:

sec. 1 T 10 N R 12 E  
S W  
10 miles S of Phila  
(distance) (direction) (nearest town)

WELL PURPOSE: (Irrigation)  
(home, irrigation, municipal, industrial)

WELL COMPLETION DATA:

- (1) diameter (inches) 4
- (2) total depth (feet) 180
- (3) static water level (feet) 30 below top of ground.
- (4) casing PVC 170  
(material) (depth)  
(size) if telescope see back.
- (5) screen 10 160  
(length) (depth to top)  
4 PVC  
(size) (material)
- (6) pump 3 70  
(HP) (yield gpm)  
E  
(type power)
- (7) electric log (yes or no)
- (organization running log)
- (8) how well bottom plugged Plug

RECEIVED


NOV 26 1990

Department of Natural Resources  
Bureau of Land & Water Resources

DRILLERS REMARKS:

If well telescopes please  
sketch and show depths.

GROUND LEVEL

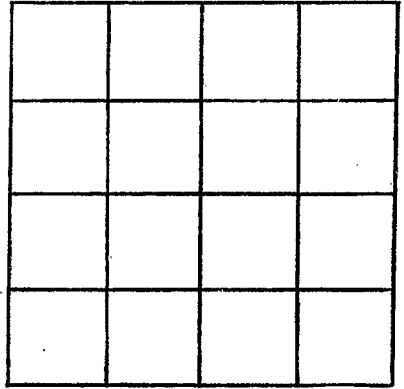

SECTION \_\_\_\_\_

Please indicate well location X.

ADDITIONAL INFORMATION

If more than one screen,  
show locations of each on sketch.