

Corrected
4/24/68
SK

5 13T

MISSISSIPPI
BOARD OF WATER COMMISSIONERS
416 North State Street
Jackson, Mississippi 39201

CODED

WATER WELL DRILLERS LOG

NESHABA
M 1
3-68

March 16 1968 Beck Smith Neshaba
date well completed firm name county well located

LANDOWNER: Gene Johnson

Route 1
Phila. Miss
(mailing address)

description of formations encountered	from	to
	red clay	0
blue chalk	10	250
blue gray sand	250	270


WELL LOCATION:
sec. 4 T 10 N S R 13 E W
8 miles E of Phila
(distance) (direction) (nearest town)

WELL PURPOSE: home
(home, irrigation, municipal, industrial)

WELL COMPLETION DATA:

- (1) diameter (inches) 2"
- (2) total depth (feet) 270'
- (3) static water level (feet) 55' below above top of ground.
- (4) casing Galv. 126' (material) (depth)
if telescope see back.
(size)
- (5) screen (length) (depth to top)
(size) (material)
- (6) pump 1 (HP) (yield gpm)
elec (type power)
- (7) electric log no (yes or no)
(organization running log)
- (8) how well bottom plugged


CODED

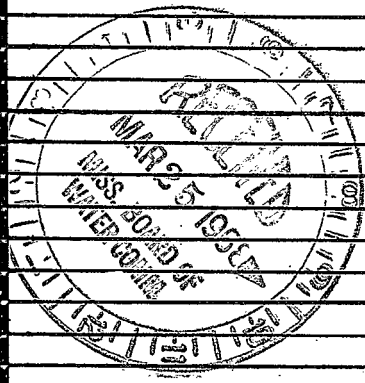

DRILLERS REMARKS:
open well

If well telescopes please sketch and show depths.

GROUND LEVEL

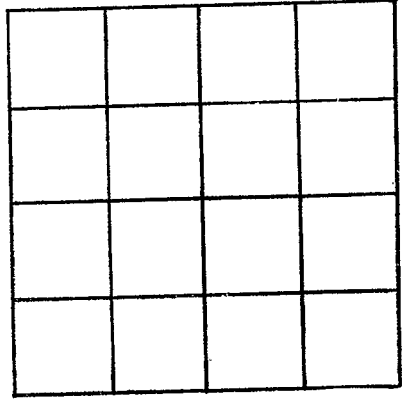

SECTION _____

Please indicate well location X.

ADDITIONAL INFORMATION

If more than one screen,
show locations of each on sketch.