

MISSISSIPPI BOARD OF WATER COMMISSIONERS

Neshoba
M 2
9-66

5 137

WATER WELL DRILLERS LOG

Date: 9-13 ^{CODED} 1966, Driller: R.R. Nicholson County Neshoba
(Name)

(1) Owner of Land: Edward Hall
(Name)
Dekalb Miss
(Address)

(2) Location: 1/4, 1/4, Sec. 12 T. 10R13,
9 miles West, of Dekalb
(distance) (direction) (Nearest Town)

(3) Topography: Hilly
(Hilly) (Flat) (Level)

(4) Purpose of Well: Domestic
(Domestic Irrigation
Municipal, Industrial, Other)

Description & Color of Materials Sand, Clay, Red Clay, Shell, etc.	Thick- ness Feet	Depth Feet
<u>Clay & sand</u>	<u>0</u>	<u>30</u>
<u>Blue dirt</u>	<u>30</u>	<u>110</u>
<u>Shell & blue dirt</u>	<u>110</u>	<u>130</u>
<u>Blue dirt</u>	<u>130</u>	<u>240</u>
<u>blue dirt & sand</u>	<u>240</u>	<u>260</u>
<u>Water sand</u>	<u>260</u>	<u>276</u>

Information upon completion of well:

(1) Diameter 4" inches.

(2) Total Depth 276 feet.

(3) Water Level 190 feet below top of ground.

(4) Cased to bottom Size 2"


(5) Screen: Size 1 1/4", Length 5 ft.

(6) Were any formations sealed against pollution?
yes, no.

If YES depth of formation _____
Why _____

Drillers Remarks: Good well

CODED
MAY 14 1966
MISS. Bd. of
WATER COMM.

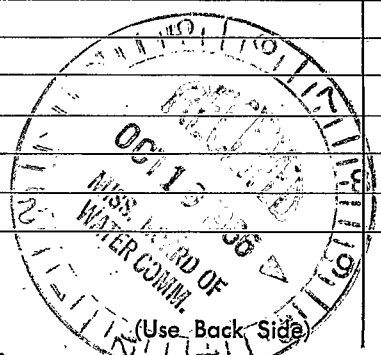

Well No.

