

Neshoba
MS CODED
 7-68

MISSISSIPPI
 BOARD OF WATER COMMISSIONERS
 416 North State Street
 Jackson, Mississippi 39201

WATER WELL DRILLERS LOG

July 18 1968 Ogletree Drilling Neshoba
 date well completed firm name county well located

LANDOWNER:
 Alvin Mc Lane
 Rt. 2 Phila.
 (mailing address)

description of formations encountered	from	to
Red clay	0	20
Blue Chalk	20	110
Blue Sand	110	168

WELL LOCATION:
 sec. 12 T. 10 N. R. 13 E.
 S W
 10 miles S. E. of Phila.
 (distance) (direction) (nearest town)

WELL PURPOSE: *Home*
 (home, irrigation, municipal, industrial)

WELL COMPLETION DATA: 11

(1) diameter (inches) 2

(2) total depth (feet) 168

(3) static water level (feet) 40 ^{below} _{above} top of ground.

(4) casing Gal. 105
 (material) (depth)
 (size) if telescope see back.

(5) screen NONE
 (length) (depth to top)
NONE
 (size) (material)

(6) pump 5 11.5
 (HP) (yield gpm)
Elec.
 (type power)

(7) electric log NO.
 (yes or no)
 (organization running log)

(8) how well bottom plugged Open

CODED


AUG 12 1968

MISS. BD. OF
 WATER COMMISSIONERS

DRILLERS REMARKS:

If well telescopes please sketch and show depths.

GROUND LEVEL

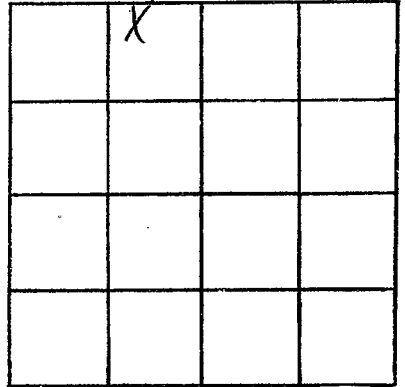

SECTION _____

Please indicate well location X.

ADDITIONAL INFORMATION

If more than one screen, show locations of each on sketch.