

Neshoba
M 7
12-6-68

MISSISSIPPI
BOARD OF WATER COMMISSIONERS
416 North State Street
Jackson, Mississippi 39201

CODED

WATER WELL DRILLERS LOG

12-6 1968 Beck Smith Neshoba
date well completed firm name county well located

LANDOWNER: Clarence Stober

description of formations encountered

from

to

Rt 3

Red Clay

0 45

Phila, Miss
(mailing address)

Blue dirt

45 90

WELL LOCATION:

Gray sand

90 105

sec. 3 T 10 N R 13 E
S W
1 1/2 miles S-E of Phila.
(distance) (direction) (nearest town)

WELL PURPOSE: home
(home, irrigation, municipal, industrial)

WELL COMPLETION DATA:

(1) diameter (inches) 2"

(2) total depth (feet) 105

(3) static water level (feet) 25 below above top of ground.

(4) casing galv, 100,
(material) (depth)

2" If telescope see back.
(size)

(5) screen 5', 100
(length) (depth to top)

.008, stainless steel
(size) (material)

(6) pump 1 (HP) (yield gpm)

elec
(type power)

(7) electric log no
(yes or no)

(organization running log)

(8) how well bottom plugged back wash valve


DRILLERS REMARKS:

CODED

FEB 13 1969
MISS. Bd. of WATER COMMISSIONERS

If well telescopes please sketch and show depths.

GROUND LEVEL

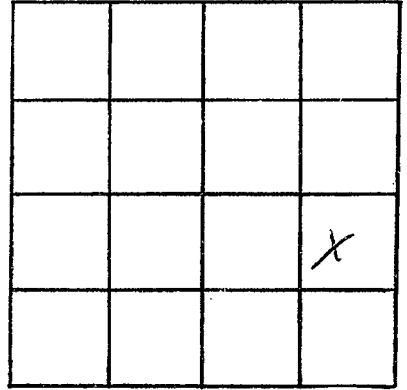

SECTION 3

Please indicate well location X.

ADDITIONAL INFORMATION

If more than one screen,
show locations of each on sketch.