

Neshoba
 M8
 4-8-69

MISSISSIPPI
 BOARD OF WATER COMMISSIONERS
 416 North State Street
 Jackson, Mississippi 39201

CODED

WATER WELL DRILLERS LOG

4-8-69 date well completed
 Ogletree Drilling Neshoba firm name
 county well located

LANDOWNER:

Newell Stoddall

Rauto 2 Phila. Miss
 (mailing address)

WELL LOCATION:

sec. 17 T. 10 N R. 13 E
 S W
 12 miles S-E of Phila.
 (distance) (direction) (nearest town)

WELL PURPOSE: Home Use
 (home) irrigation, municipal, industrial

WELL COMPLETION DATA:

- (1) diameter (inches) 2"
- (2) total depth (feet) 300
- (3) static water level (feet) 140 below above top of ground.
- (4) casing None 210 (material) (depth)
 (size) if telescope see back.
- (5) screen None (length) (depth to top)
 (size) (material)
- (6) pump 3/4 4.5 (HP) (yield gpm)
P.C.A.
 (type power)
- (7) electric log _____
 (yes or no)
 (organization running log)
- (8) how well bottom plugged Open

description of formations encountered

from

to

Red clay	0	10
Red sand	20	30
Black Chalk	30	250
Blue sand	250	300


CODED

DRILLERS REMARKS:

APR 7 1969
 MISS. Bd. OF WATER COMMISSIONERS

If well telescopes please sketch and show depths.

GROUND LEVEL

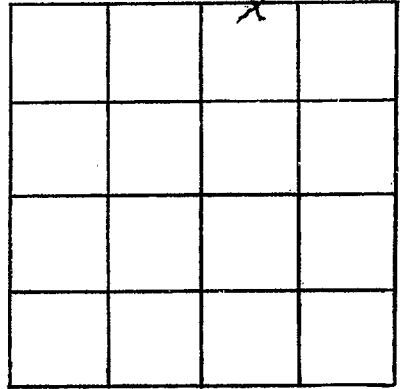

SECTION 12

Please indicate well location X.

ADDITIONAL INFORMATION

If more than one screen, show locations of each on sketch.