

MEMPHIS  
 CM10  
 8-5-60

6-137  
 CODED WATER WELL DRILLERS LOG

Date: 8-85, 1960, Driller: R.R. Nicholson County: Nechaha  
 (Name)

(1) Owner of Land: EA. Alderman  
 (Name)  
Phila. Miss.  
 (Address)  
10 10 13  
 (2) Location: 1/4, 1/4, Sec. T R  
 \_\_\_\_\_ miles \_\_\_\_\_ of \_\_\_\_\_  
 (distance) (direction) (Nearest Town)  
 (3) Topography: Flat  
 (Hilly) (Flat) (Level)  
 (4) Purpose of Well:  
 (Domestic Irrigation  
 Municipal, Industrial, Other)


Description & Color of Materials Sand, Clay, Red Clay, Shell, etc.	Thick- ness Feet	Depth Feet
<u>Clay &amp; Shell</u>	<u>1</u>	<u>30</u>
<u>Shell rock &amp; blue</u>	<u>30</u>	<u>40</u>
<u>Sand &amp; dirt</u>	<u>40</u>	<u>50</u>
<u>Blue dirt &amp; shell</u>	<u>50</u>	<u>120</u>
<u>Sand &amp; dirt</u>	<u>120</u>	<u>135</u>
<u>Water Sand</u>	<u>135</u>	<u>160</u>

Information upon completion of well:

(1) Diameter 4 1/2 inches.  
 (2) Total Depth \_\_\_\_\_ feet.  
 (3) Water Level \_\_\_\_\_ feet below top of ground.  
 (4) Cased to \_\_\_\_\_, Size \_\_\_\_\_  
 (5) Screen: Size \_\_\_\_\_, Length \_\_\_\_\_  
 (6) Were any formations sealed against pollution?  
 \_\_\_\_\_ yes, \_\_\_\_\_ no.

If YES depth of formation \_\_\_\_\_  
 Why \_\_\_\_\_  
 Drillers Remarks: \_\_\_\_\_

CODED

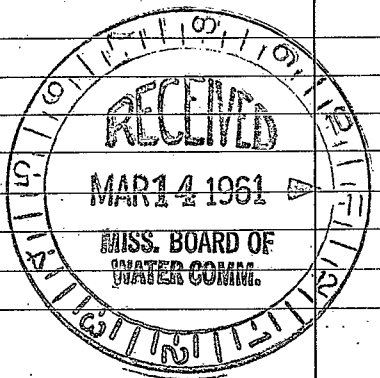

(Use Back Side)

Well No.

Handwritten text, likely bleed-through from the reverse side of the page. The text is mostly illegible due to fading and the quality of the scan.

Handwritten text, likely bleed-through from the reverse side of the page. The text is mostly illegible due to fading and the quality of the scan.