

NEHOBA

MISSISSIPPI BOARD OF WATER COMMISSIONERS

H MII

6 137
CODED

WATER WELL DRILLERS LOG

9-20-63

Date: 9-20, 1963, Driller: W. J. Gray County: Neshoba
(Name)

(1) Owner of Land:	Description & Color of Materials Sand, Clay, Red Clay, Shell, etc.	Thick- ness Feet	Dept Fee
<u>Billie Eakes</u> (Name) <u>Phil miss Rt 2</u> (Address)	<u>Blue Clay</u> <u>to 100 ft</u>		
(2) Location: <u>1/4, 2, 10 13</u> <u>11 miles East</u> , of <u>Phila</u> (distance) (direction) (Nearest Town)	<u>Sand Gray</u> <u>110-120 ft fine</u>		
(3) Topography: <input checked="" type="checkbox"/> (Hilly) <input type="checkbox"/> (Flat) <input type="checkbox"/> (Level)			
(4) Purpose of Well: <u>Domestic</u> (Domestic Irrigation Municipal, Industrial, Other)			

Information upon completion of well:


- (1) Diameter 2 inches.
- (2) Total Depth 120 feet.
- (3) Water Level 40 feet below top of ground.
- (4) Cased to 84, Size 2 in
- (5) Screen: Size 2 in Length _____
- (6) Were any formations sealed against pollution?
_____ yes, no.

If YES depth of formation _____

Why _____

Drillers Remarks: _____

CODED

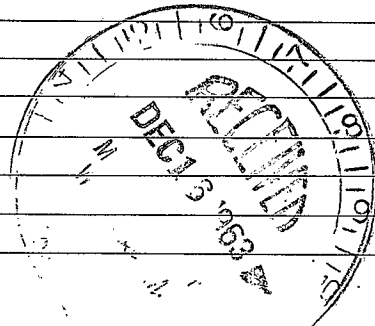

(Use Back Side)

Well No.

