

NESHOPA

MISSISSIPPI BOARD OF WATER WELL DRILLERS

M12

WATER WELL DRILLERS LOG

Date: 1-8-65, 1965 Driller: Bob Williamson County Nebraska
(Name)

(1) Owner of Land: Edwin Richards
(Name)
Philadelphia Miss.
(Address)

(2) Location: 8 10 13
8 miles S.E. of Phid.
(distance) (direction) (Nearest Town)

(3) Topography: hilly
(Hilly) (Flat) (Level)

(4) Purpose of Well: Domestic
(Domestic Irrigation
Municipal, Industrial, Other)

Description & Color of Materials Sand, Clay, Red Clay, Shell, etc.	Thick- ness Feet	Depth Feet
<u>Blue clay</u>	<u>25</u>	<u>1-25</u>
<u>gray sand</u>	<u>5</u>	<u>25-30</u>
<u>Blue clay</u>	<u>75</u>	<u>30-105</u>
<u>White sand</u>	<u>20</u>	<u>105-125</u>

Information upon completion of well:

(1) Diameter 2 inches.

(2) Total Depth 125 feet.

(3) Water Level 30 feet below top of ground.

(4) Cased to 120, Size 2"

(5) Screen: Size 2" 12 slate, Length 5 ft.


(6) Were any formations sealed against pollution?
no.

CODED

CODED

If YES depth of formation
Why

Drillers Remarks:

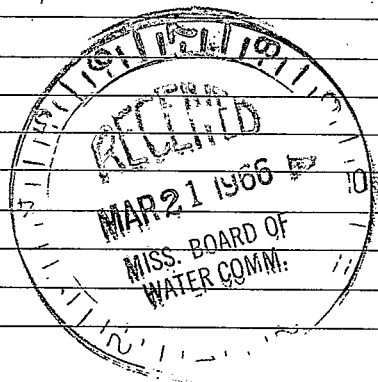

(Use Back Side)

Well No.

Retain this copy for your office files.

