

MISSISSIPPI BOARD OF WATER COMMISSIONERS

NEHOBA
P M 13

CODED

WATER WELL DRILLERS LOG

6 135

Date: 5-2, 1961, Driller: B. B. Nicholas, County Neshoba
 5-2-61 (Name)

(1) Owner of Land: Bob Calvert
 (Name)
Phila. Miss
 (Address)
25 10 13
 (2) Location: 1/4, 1/4, Sec. T R
10 miles S-East of Phila.
 (distance) (direction) (Nearest Town)
 (3) Topography: Hilly
 (Hilly) (Flat) (Level)
 (4) Purpose of Well: Domestic
 (Domestic Irrigation
 Municipal, Industrial, Other)

Description & Color of Materials Sand, Clay, Red Clay, Shell, etc.	Thick- ness Feet	Depth Feet
<u>1-60 Clay & Sand</u>	<u>1</u>	<u>60</u>
<u>Blue dirt</u>	<u>60</u>	<u>120</u>
<u>rock</u>	<u>20</u>	<u>134</u>
<u>black dirt</u>	<u>134</u>	<u>205</u>
<u>Water Sand</u>	<u>205</u>	<u>238</u>


Information upon completion of well:

(1) Diameter 4 1/2 inches.
 (2) Total Depth 238 feet.
 (3) Water Level 99 feet below top of ground.
 (4) Cased to 105, Size 2"
 (5) Screen: Size _____, Length _____
 (6) Were any formations sealed against pollution?
 _____ yes, _____ no.

CODED

If YES depth of formation _____
 Why _____

Drillers Remarks: Good well
this well is pump ?
with screen

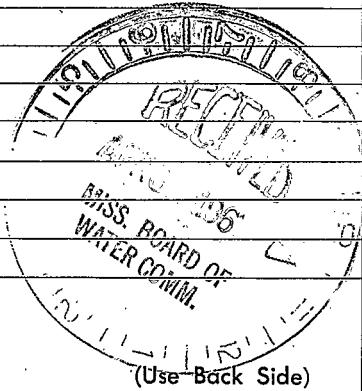

Well No.

