

NESHOPA

MISSISSIPPI BOARD OF WATER COMMISSIONERS

BM14

6 13T

11-12-64 CODED

WATER WELL DRILLERS LOG

Date: 11-12, 1964, Driller: Bob Williams County Lauderdale

(Name)

(1) Owner of Land: Joe Moody (Name)

Route # 3 Union Miss (Address)

(2) Location: 1/4, 30 10 13, Sec. T R

10 miles S.E. of Philadelphia (distance, direction, Nearest Town)

(3) Topography: hilly (Hilly, Flat, Level)

(4) Purpose of Well: Domestic (Domestic Irrigation, Municipal, Industrial, Other)

Description & Color of Materials Sand, Clay, Red Clay, Shell, etc.	Thick- ness Feet	Depth Feet
Red sand	15	1-15
Blue Clay	160	15-175
fine gray sand	15	175-190
Blue clay	20	190-210
white sand	30	210-240

Information upon completion of well:

(1) Diameter 2 inches.

(2) Total Depth 240 feet.

(3) Water Level 109 feet below top of ground.

(4) Cased to 234, Size 2

(5) Screen: Size 2, Length 6"

(6) Were any formations sealed against pollution?


yes, no.

If YES depth of formation

Why

Drillers Remarks:

CODED

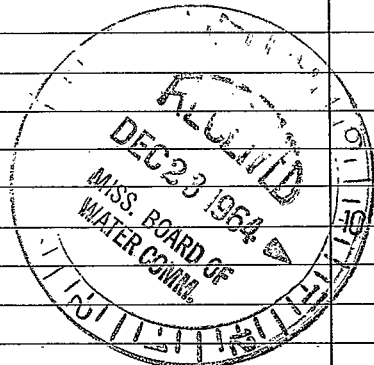

(Use Back Side)

Well No.

