

Neshoba  
M16  
12-8-69

MISSISSIPPI  
BOARD OF WATER COMMISSIONERS  
416 North State Street  
Jackson, Mississippi 39201

CODED

CODED

WATER WELL DRILLERS LOG

12-8

1969

B B Nicholson

Neshoba

date well completed

firm name

county well located


LANDOWNER: Roy wells	description of formations encountered	from	to
Shila	Chalk & Clay	0	27
Miss -	Mud Sand & Shale	27	70
(mailing address)	Water Sand	70	84
<b>WELL LOCATION:</b>			
sec. 3 T. 13 N. R. 13 E. 9 miles E of Shila (distance) (direction) (nearest town)			
<b>WELL PURPOSE:</b> Home (home, irrigation, municipal, industrial)			
<b>WELL COMPLETION DATA:</b>			
(1) diameter (inches) 4 1/4			
(2) total depth (feet) 84			
(3) static water level (feet) 16.5 below top of ground.			
(4) casing (material) Galv. (depth) 79 2" (size) if telescope see back.			
(5) screen (length) 51 (depth to top) 84 1/4" (size) Steel (material)			
(6) pump (HP) 1 (yield gpm) 11 Elect (type power)			
(7) electric log (yes or no)			
(organization running log)			
(8) how well bottom plugged			
DRILLERS REMARKS:			

JAN 21 1970

MISS. RD. OF  
WATER COM.

If well telescopes please sketch and show depths.

GROUND LEVEL

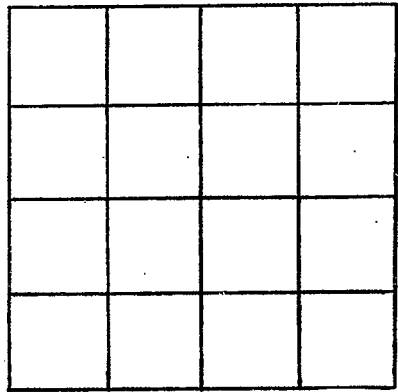

SECTION 3

Please indicate well location X.

ADDITIONAL INFORMATION

Lined area for additional information, consisting of multiple horizontal lines for text entry.

If more than one screen, show locations of each on sketch.