

MISSISSIPPI
BOARD OF WATER COMMISSIONERS
416 North State Street
Jackson, Mississippi 39201

coded


WATER WELL DRILLERS LOG

Neshoba
M 19
6-3-70

6-3 19 70 Oglethorpe Drilling Co. Neshoba
date well completed firm name county well located


LANDOWNER:	description of formations encountered	from	to
<u>Wilson, Dewese</u> <u>Rt. 4 Phila. Miss</u> (mailing address)	<u>Red Clay</u> <u>blue shell</u> <u>Red sand</u>	<u>0</u> <u>20</u> <u>30</u>	<u>20</u> <u>30</u> <u>110</u>
WELL LOCATION: sec. <u>13</u> T. <u>10</u> (N) R. <u>13</u> (E) <u>9</u> miles <u>S.E.</u> of <u>Phila.</u> (distance) (direction) (nearest town)			
WELL PURPOSE: <u>home</u> (home, irrigation, municipal, industrial)			
WELL COMPLETION DATA: (1) diameter (inches) <u>2"</u> (2) total depth (feet) <u>110'</u> (3) static water level (feet) <u>40</u> ^{below} _{above} top of ground. (4) casing <u>Galv.</u> <u>105'</u> (material) (depth) (size) if telescope see back. (5) screen <u>6</u> <u>110'-104'</u> (length) (depth to top) <u>1 1/4"</u> <u>Stainless steel</u> (size) (material) (6) pump <u>3/4</u> <u>4</u> (HP) (yield gpm) <u>Elec.</u> (type power) (7) electric log <u>NO.</u> (yes or no) (organization running log) (8) how well bottom plugged <u>Partial</u>			
DRILLERS REMARKS:			

DATE 6-2 1970

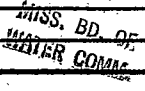MISS. BD. OF
WATER COM. 

If well telescopes please sketch and show depths.

GROUND LEVEL

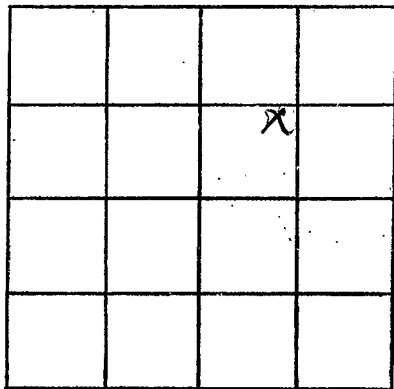

SECTION 13

Please indicate well location X.

ADDITIONAL INFORMATION

If more than one screen, show locations of each on sketch.