

② Indian

NESHOBA  
M 22  
9-22-70

MISSISSIPPI  
BOARD OF WATER COMMISSIONERS  
416 North State Street  
Jackson, Mississippi 39201

**CODED**

WATER WELL DRILLERS LOG

9-22 date well completed 1970 firm name *Sater & Sater* Neshoba county well located

LANDOWNER:

*Ernest Fringer*  
*P.O. Phila. Miss.*  
(mailing address)

description of formations encountered

from to

*clay* 20 ft  
*shaly clay* 1 90  
*sn. ipd. sd* 20  
*water sand* 40

WELL LOCATION:

sec. 11 T. 10 N R. 13 E  
S W  
12 miles *East* of *Phila.*  
(distance) (direction) (nearest town)

WELL PURPOSE:

(home, irrigation, municipal, industrial)

WELL COMPLETION DATA:

- (1) diameter (inches) 4
- (2) total depth (feet) 270
- (3) static water level (feet) 105 below above top of ground.
- (4) casing 4" Black, 260  
(material) (depth)  
         if telescope see back.  
(size)
- (5) screen 10, 260  
(length) (depth to top)  
2", Johnson sd.  
(size) (material)
- (6) pump 3/4, 10  
(HP) (yield gpm)  
REA  
(type power)
- (7) electric log           
(yes or no)  
          
(organization running log)
- (8) how well bottom plugged SW

**CODED**


DRILLERS REMARKS:

MISS. Bd. of  
WATER COM. 5 1970

If well telescopes please sketch and show depths.

GROUND LEVEL

*Willy*

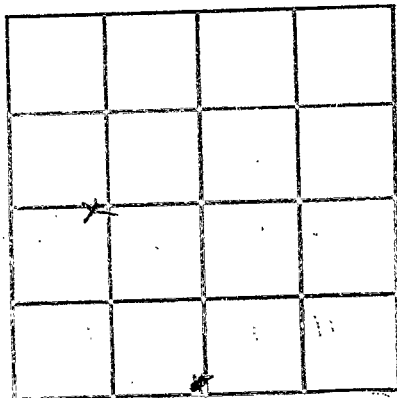

SECTION 2

Please indicate well location X.

ADDITIONAL INFORMATION

If more than one screen,  
show locations of each on sketch.