

MISSISSIPPI  
BOARD OF WATER COMMISSIONERS  
416 North State Street  
Jackson, Mississippi 39201

**CODED**

WATER WELL DRILLERS LOG

NESHOBA  
M 23  
12-10-70

12-10 date well completed      1970 P P Y Nicholson firm name      Neshoba county well located

LANDOWNER: A C McNeil  
Chila  
Miss  
(mailing address)

description of formations encountered	from	to
<u>Clay &amp; silt</u>	<u>0</u>	<u>20</u>
<u>blue dirt</u>	<u>20</u>	<u>60</u>
<u>sand mix dirt</u>	<u>60</u>	<u>90</u>
<u>water dirt</u>	<u>82-89</u>	

WELL LOCATION:  
sec. 17 T. 10 N R. 13 E  
7 1/2 miles South of Chila  
(distance) (direction) (nearest town)

WELL PURPOSE: home  
(home, irrigation, municipal, industrial)

WELL COMPLETION DATA:

(1) diameter (inches) 4 1/4

(2) total depth (feet) 89

(3) static water level (feet) 50 below above top of ground.

(4) casing Galv. 84  
(material) (depth)  
2" if telescope see back.  
(size)

(5) screen 5' 89  
(length) (depth to top)  
1 1/4 Steel  
(size) (material)

(6) pump 1 9  
(HP) (yield gpm)  
Elect  
(type power)

(7) electric log             
(yes or no)

            
(organization running log)

(8) how well bottom plugged           

**CODED**


DEC 15 1970

MISS. SU. CO.

DRILLERS REMARKS:

If well telescopes please sketch and show depths.

GROUND LEVEL

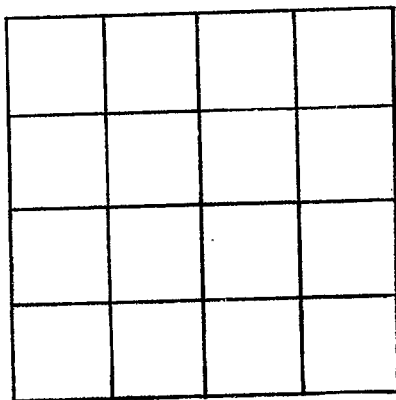

SECTION \_\_\_\_\_

Please indicate well location X.

ADDITIONAL INFORMATION

If more than one screen, show locations of each on sketch.