

NESHOBIA
M 25
12-10-70

MISSISSIPPI
BOARD OF WATER COMMISSIONERS
416 North State Street
Jackson, Mississippi 39201

CODED

WATER WELL DRILLERS LOG

12-10-1970 date well completed
 Philadelpha Drilling Co. firm name
 Neshoba county well located

| LANDOWNER: Jerry Johnson | description of formations encountered | from | to |
|--------------------------|---------------------------------------|------|-----|
| Philadelpha Drilling Co. | | | |
| | Blue Clay | 3 | 35 |
| | sand | 35 | 64 |
| | Blue Clay | 64 | 149 |
| | gray sand | 149 | 195 |

(mailing address)

WELL LOCATION:
 sec. 14 T. 10N R. 13E
 12 miles East of Philadelpha
 (distance) (direction) (nearest town)

WELL PURPOSE: Home
 (home, irrigation, municipal, industrial)

- WELL COMPLETION DATA:
- (1) diameter (inches) 2
 - (2) total depth (feet) 195
 - (3) static water level (feet) 74 below top of ground.
 - (4) casing galv. 143 (material) (depth)
 2 (size) if telescope see back.
 - (5) screen na (length) (depth to top)
 (size) (material)
 - (6) pump 1 (HP) 7 (yield gpm)
 Elect. (type power)
 - (7) electric log na (yes or no)
 na (organization running log)
 - (8) how well bottom plugged Open

CODED


MAR 9 1971

DRILLERS REMARKS:

MISS. Bd. OF
 WATER CONTROL

If well telescopes please sketch and show depths.

GROUND LEVEL

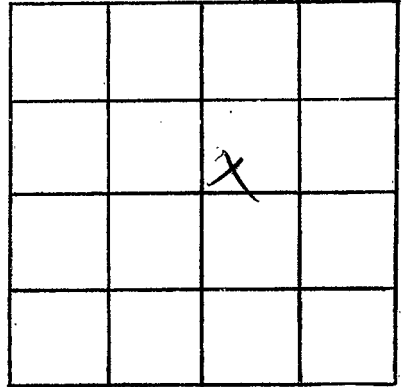

SECTION 14

Please indicate well location X.

ADDITIONAL INFORMATION

If more than one screen,
show locations of each on sketch.