

**CODED**

MISSISSIPPI  
BOARD OF WATER COMMISSIONERS

416 North State Street  
Jackson, Mississippi 39201

FEB 18 1972

WATER WELL DRILLERS LOG

MISS. BO. W. C.

Neshoba  
M 28  
11-6-71

11-6-71 19  
date well completed

Beck Smith  
firm name

Neshoba  
county well located

LANDOWNER:  
Jerry Stokes  
Phila miss  
(mailing address)

description of formations encountered	from to	
	feet	feet
red clay	0	40
blue chalk	40	85
blue sand	85	110

WELL LOCATION:  
sec. 3 T 10 N R 13 E  
7 miles <sup>S</sup> <sub>W</sub> of Phila  
(distance) (direction) (nearest town)

WELL PURPOSE: home  
(home, irrigation, municipal, industrial)

WELL COMPLETION DATA:

(1) diameter (inches) 2"

(2) total depth (feet) 110'

(3) static water level (feet) 50' <sup>below</sup> <sub>above</sub> top of ground.

(4) casing Galv. 105' (material) (depth)  
2" (size) if telescope see back.

(5) screen 5' 105' (length) (depth to top)  
008, stainless steel (size) (material)

(6) pump 1 HP (HP) (yield gpm)  
elec (type power)

(7) electric log no (yes or no)  
(organization running log)


(8) how well bottom plugged

**CODED**

DRILLERS REMARKS:

If well telescopes please sketch and show depths.

GROUND LEVEL

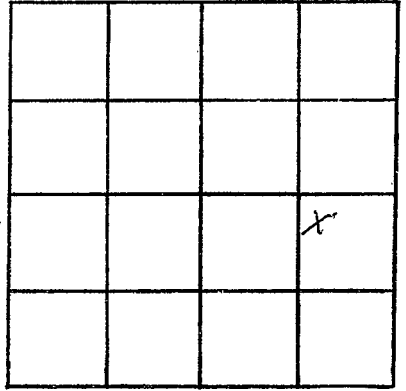

SECTION 3

Please indicate well location X.

ADDITIONAL INFORMATION

If more than one screen,  
show locations of each on sketch.