

M ~~32~~ 32
 NESHABA
 8-13-73

MISSISSIPPI
 BOARD OF WATER COMMISSIONERS
 416 North State Street
 Jackson, Mississippi 39201

CODED

WATER WELL DRILLERS LOG

8-13-73 1923 Beck Smiths Neshoba
 date well completed firm name county well located

LANDOWNER:	description of formations encountered	from	to
Mamie Gads	red clay	0	20
Phila, Miss (mailing address)	blue chalk	20	70
	gray sand	70	90

WELL LOCATION:
 sec. 3 T. 10 N. R. 13 E
 8 miles SE of Phila
 (distance) (direction) (nearest town)

WELL PURPOSE: home
 (home, irrigation, municipal, industrial)

CODED


- WELL COMPLETION DATA:
- (1) diameter (inches) 2"
 - (2) total depth (feet) 90'
 - (3) static water level (feet) 40' below top of ground.
 - (4) casing galv. 85' (material) (depth)
 2" (size) if telescope see back.
 - (5) screen 3' 85' (length) (depth to top)
 008 Stainless Steel (size) (material)
 - (6) pump 1/2 (HP) 6 (yield gpm)
 elec (type power)
 - (7) electric log (yes or no)
 - (organization running log)
 - (8) how well bottom plugged back
 Wash valve

DRILLERS REMARKS:

AUG 25 1973

If well telescopes please sketch and show depths.

GROUND LEVEL

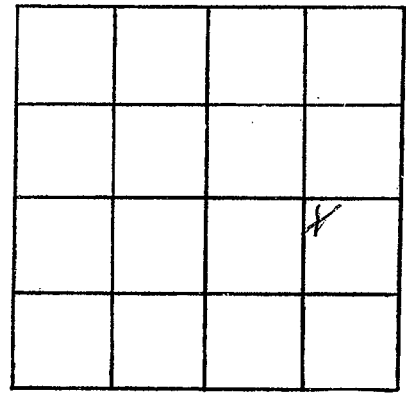

SECTION 3

Please indicate well location X.

ADDITIONAL INFORMATION

A series of horizontal lines for writing additional information, starting below the 'ADDITIONAL INFORMATION' header and extending to the bottom of the page.

If more than one screen, show locations of each on sketch.