

NESHOBA

M 2000

8-10-80

MISSISSIPPI
 BOARD OF WATER COMMISSIONERS
 416 North State Street
 Jackson, Mississippi 39201

WATER WELL DRILLERS LOG

8-10

19

80 Beck Smith

Neshoba

date well completed

firm name

county well located

LANDOWNER:

Beck Bounds

description of formations encountered

from

to

Phila. Miss
(mailing address)

red clay
chalk
gray sand

0 150
150 230
230 270

WELL LOCATION:

sec. 11 T. 10 N. R. 13 E
9 miles E of Phila
(distance) (direction) (nearest town)

WELL PURPOSE: industrial
(home, irrigation, municipal, industrial)

WELL COMPLETION DATA:

- (1) diameter (inches) 4"
- (2) total depth (feet) 270'
- (3) static water level (feet) 50' below top of ground.
- (4) casing PVC 200' (material) (depth)
- (5) screen 15' 185' (length) (depth to top)
2' PVC (size) (material)
- (6) pump 1 Sub (HP) (yield gpm)
etc. (type power)
- (7) electric log (yes or no)

(organization running log)

(8) how well bottom plugged back
wash value


DRILLERS REMARKS:

MISSISSIPPI DEPT. OF NATURAL RESOURCES BUREAU OF LAND & WATER RESOURCES

SEP 18 1980 RECEIVED

If well telescopes please sketch and show depths.

GROUND LEVEL

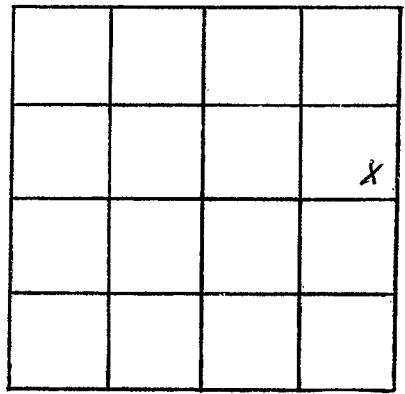

SECTION 2

Please indicate well location X.

ADDITIONAL INFORMATION

If more than one screen, show locations of each on sketch.