

Neshoba  
M 2001

MISSISSIPPI DEPARTMENT OF NATURAL RESOURCES  
 Bureau of Land and Water Resources  
 Southport Mall  
 P.O. Box 10631  
 Jackson, Mississippi 39209  
**WATER WELL DRILLERS LOG**

4-21-83 1983 F.D. Conway NESHOBA  
 date well completed firm name county well located

LANDOWNER: <u>Willy Strickland</u>	Description of formations encountered	from	to
		<u>Red Clay</u>	<u>0</u>
	<u>Rock and Shale</u>	<u>40</u>	<u>70</u>
	<u>Sand and Gravel</u>	<u>70</u>	<u>90</u>
	<u>Red Sand</u>	<u>90</u>	<u>105</u>

WELL LOCATION:  
 sec. 8 T100 R1B E  
8 miles E of Philadelphia  
 (distance) (direction) (nearest town)

WELL PURPOSE:  
 (home) irrigation, municipal, industrial

- WELL COMPLETION DATA:
- (1) diameter (inches) 2"
  - (2) total depth (feet) 105'
  - (3) static water level (feet) 2" below top of ground.
  - (4) casing 2" 98'  
 (material) (depth)  
2"  
 (size) If telescope see back.
  - (5) screen 2" P.V.C. 98'  
 (length) (depth to top)  
2" P.V.C. pipe  
 (size) (material)
  - (6) pump 1 110  
 (HP) (yield gpm)  
Elec.  
 (type power)
  - (7) electric log NO  
 (yes or no)  
Co. P.  
 (organization running log)
  - (8) how well bottom plugged \_\_\_\_\_

DRILLERS REMARKS:


DEPT. OF NATURAL RESOURCES  
 BUREAU OF LAND & WATER RESOURCES

APR 26 1983

RECEIVED

If well telescopes please sketch and show depths.

GROUND LEVEL

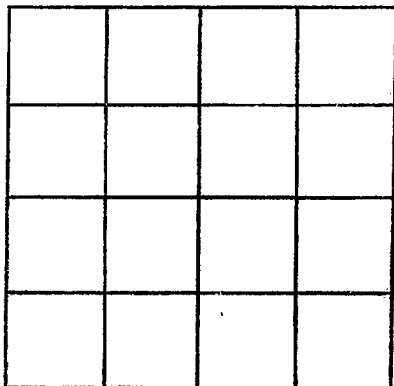

SECTION \_\_\_\_\_

Please indicate well location X.

ADDITIONAL INFORMATION

If more than one screen, show locations of each on sketch.