

MISSISSIPPI DEPARTMENT OF ENVIRONMENTAL QUALITY

Office of Land and Water Resources

P. O. Box 10631
Jackson, MS 39289-0631
WATER WELL DRILLERS LOG

COUNTY WELL LOCATED <i>Neshoba</i>	
WELL NUMBER <i>M 2005</i>	CODED
DATE WELL COMPLETED <i>6-18-96</i>	

PERMIT NUMBER
NAME OF DRILLING FIRM <i>THOMAS DRILLING</i>

NAME & MAILING ADDRESS OF LANDOWNER <i>Joe WILLIAMSON</i>		
<i>Rt 1, Box 213-A</i>		
<i>Philadelphia MS 39350</i>		
WELL LOCATION:	SEC	TOWNSHIP RANGE
	<i>22</i>	<i>100^N 13^E</i>
DISTANCE	DIRECTION	NEAREST TOWN
<i>4</i> Miles	<i>SE</i>	<i>Blome</i>
OTHER LANDMARK <i>1 M. SW Dewees</i>		
WELL PURPOSE: Home, Irrigation, Municipal, Industrial, Fish Pond, etc. <i>Chicken Houses</i>		

PUMP DATA		
PUMP TYPE (Circle One): Submersible, Turbine, <input checked="" type="radio"/> Flowing Well, Other (Describe) _____		
POWER TYPE (Circle One): <input checked="" type="radio"/> Electric, Tractor, Diesel, Gasoline, Butane, Other (Describe) _____ H/P <i>1</i>		
Pump Capacity (GPM) <i>5</i>	No. of Stages <i>2</i>	Setting Depth <i>30</i> FT.
PUMP TEST		
Well yielded <i>5</i> GPM with a drawdown of <i>N/A</i> ft. after _____ hours of pumping		

WELL DATA		
Well Depth <i>35'</i>	Casing Diameter (In.) <i>2"</i>	Casing Length (Ft.) <i>30'</i>
Type of Casing <i>PVC</i>	Hole Depth <i>35'</i>	Depth to Static Water Level <i>24'</i>

LOG DATA	
TYPE OF LOG RUN (Circle One): Electric, Gamma Ray, Density, Sonic, Neutron, Other (Describe) _____ <input checked="" type="radio"/> <i>No Log Run</i>	
Name of Organization Running Log	

TYPE OF COMPLETION: (Circle One or More): Gravel Packed, Underreamed, Telescoped, Natural Development, Open Hole, Other (Describe) _____		
WELL GROUTED TO A DEPTH OF _____ FEET Type Grout (circle one): Cement, Bentonite, or Mix		

GEOLOGIC DATA (Office Use Only)			
Surface Elev.	Geologic Unit	Unit Thickness	Depth to Top
Subs. SWL	Date	Analysis	Aquifer Test
Driller's Remarks			
Top of Lap Pipe or Reduction in Casing			
FEET		IF TELESCOPED OR MORE THAN ONE SCREEN: USE BACK PAGE	

SCREEN DATA		
Diameter - Inches <i>2"</i>	Length - Feet <i>5'</i>	Slot Size - Inches <i>.010</i>
Screen Type <i>PVC wrapped</i>	Depth to Bottom - Feet <i>35'</i>	


DESCRIPTION OF FORMATIONS ENCOUNTERED	FROM	TO
<i>Dirt</i>	<i>0</i>	<i>3</i>
<i>clay</i>	<i>3</i>	<i>6</i>
<i>sand</i>	<i>6</i>	<i>35</i>

FORMATIONS (Continued)	FROM	TO
RECEIVED		
AUG 20 1997		

IF MORE SPACE IS NEEDED, USE BACK

If well telescopes please sketch and show depths.

GROUND LEVEL

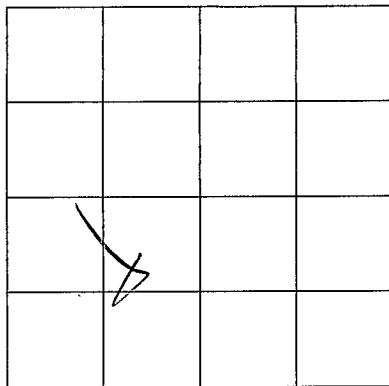

SECTION 22

Please indicate well location X.

ADDITIONAL INFORMATION

If more than one screen,
show location of each on sketch.