

N 1

5 13 T

N 30

7-7-60 CODED WATER WELL DRILLERS LOG

Date: 7-7, 1960, Driller: R R Nicholson County Neshoba

(Name)

(1) Owner of Land: John H Reagan (Name) Union Miss (Address)

Description & Color of Materials Sand, Clay, Red Clay, Shell, etc.	Thick- ness Feet	Depth Feet
Red Clay	18	18
Mix sand & clay	18	60
Water Sand	16	73

(2) Location: 1/4, 1/4, Sec. 25 T9R10 8 miles West of Union (distance) (direction) (Nearest Town)

(3) Topography: Hilly (Hilly) (Flat) (Level)

(4) Purpose of Well: Home use (Domestic Irrigation Municipal, Industrial, Other)

Information upon completion of well:

(1) Diameter 4 1/2 inches.

(2) Total Depth 73 feet.

(3) Water Level 40 feet below top of ground.

(4) Cased to 67, Size 2"

(5) Screen: Size 10, Length 6 ft


(6) Were any formations sealed against pollution? yes, no no.

If YES depth of formation

Why

Drillers Remarks: good well easy drilling

CODED

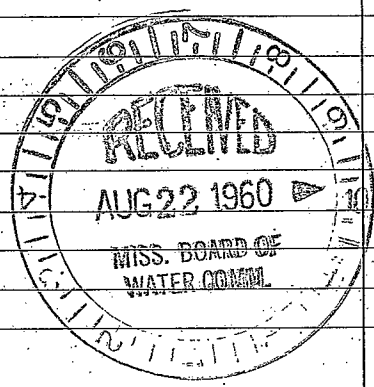

(Use Back Side)

Well No.

