

NESHOBAMA

MISSISSIPPI BOARD OF WATER COMMISSIONERS

N 2

5 131

CODED WATER WELL DRILLERS LOG

14

5-23-62

Date: 5-23, 1962, Driller: Marshall Compton County: Neshoba

(Name)

- (1) Owner of Land: R. W. Shaw
(Name)
Union #1 M 55
(Address)
- (2) Location: 1/4, 1/4, Sec 20 T 9 R 10,
S miles East, of Sublet
(distance) (direction) (Nearest Town)
- (3) Topography: X
(Hilly) (Flat) (Level)
- (4) Purpose of Well: Domestic
(Domestic Irrigation
Municipal, Industrial, Other)

Description & Color of Materials Sand, Clay, Red Clay, Shell, etc.	Thick- ness Feet	Depth Feet
Clay		20
Clay	20	100
Clay	60	160
Very Coarse Sand	20	180
Water Table	185	240
Rock	240	241
at 240 ft	241	280


Information upon completion of well:

- (1) Diameter 2 inches.
- (2) Total Depth 280 feet.
- (3) Water Level 75 feet below top of ground.
- (4) Cased to 189, Size _____
- (5) Screen: Size _____, Length _____
- (6) Were any formations sealed against pollution?
X yes, _____ no.

If YES depth of formation 189
Why stated above. was bad

Drillers Remarks:

CODED

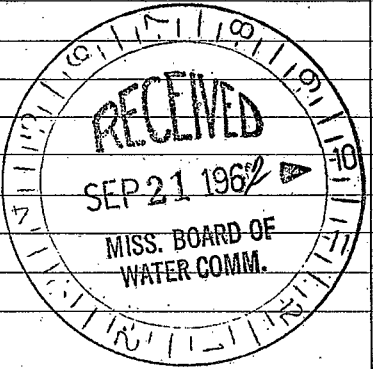

(Use Back Side)

Well No.

