

NESHOBBA

CODED 5 137

N 5

WATER WELL DRILLERS LOG

3-23-63

Marshall Comans

Date: 3-23, 1963, Driller: Ray Cox (Name)

County Neshoba

(1) Owner of Land: FAML MAJOR
 (Name)
Amos R
 (Address)

(2) Location: 1/4, 1/4, Sec 19 T 9 R 10
3 miles N-E of Schantal
 (distance) (direction) (Nearest Town)

(3) Topography: X
 (Hilly) (Flat) (Level)

(4) Purpose of Well: Domestic
 (Domestic Irrigation
 Municipal, Industrial, Other)

Description & Color of Materials Sand, Clay, Red Clay, Shell, etc.	Thick- ness Feet	Depth Feet
0 to 15 Clay		
15 to 105 Sand		
105 to 130 Chick peas & Chicks		
130 to 180 Brown Gypsum		
Clay, 180 to 183 Rocks		
183 to 214 Shell Rock & Sand		
214 to 230 Green Sand		

Information upon completion of well:

(1) Diameter 2" inches.

(2) Total Depth 230 feet.

(3) Water Level 37' feet below top of ground.

(4) Cased to 147', Size 2"

(5) Screen: Size None, Length _____


(6) Were any formations sealed against pollution?
 _____ yes, _____ no.

If YES depth of formation _____

Why _____

Drillers Remarks: _____

Comans Well Drilling
Schantal Miss

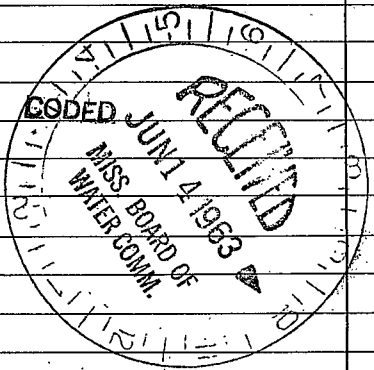

(Use Back Side)

Well No.

