

NESHoba

N 6 CODED

3-68

MISSISSIPPI  
 BOARD OF WATER COMMISSIONERS  
 416 North State Street  
 Jackson, Mississippi 39201

WATER WELL DRILLERS LOG

3-28 1968 Common Drilling Service Neshoba  
 date well completed firm name county well located

LANDOWNER: John Hillins

R#1 Union

Miss  
 (mailing address)

WELL LOCATION:

sec. 28 T. 9 N R. 16 E  
 S W  
3 miles North of Sebaston  
 (distance) (direction) (nearest town)

WELL PURPOSE: Home  
 (home, irrigation, municipal, industrial)

WELL COMPLETION DATA:

- (1) diameter (inches) 2
- (2) total depth (feet) 165
- (3) static water level (feet) 0 below above top of ground.
- (4) casing 2, 34,  
 (material) (depth)  
 \_\_\_\_\_ if telescope see back.  
 (size)
- (5) screen \_\_\_\_\_, \_\_\_\_\_  
 (length) (depth to top)  
 \_\_\_\_\_, \_\_\_\_\_  
 (size) (material)
- (6) pump \_\_\_\_\_, \_\_\_\_\_  
 (HP) (yield gpm)  
 \_\_\_\_\_  
 (type power)
- (7) electric log \_\_\_\_\_  
 (yes or no)  
 \_\_\_\_\_  
 (organization running log)
- (8) how well bottom plugged \_\_\_\_\_

description of formations encountered

from to

<u>Clay</u>	<u>0</u>	<u>15</u>
<u>Bond</u>	<u>15</u>	<u>60</u>
<u>Clay</u>	<u>60</u>	<u>130</u>
<u>Bond</u>	<u>130</u>	<u>165</u>


CODED

JUN 5 1968  
 MISS. BOARD OF  
 WATER COM.

DRILLERS REMARKS:

If well telescopes please sketch and show depths.

GROUND LEVEL

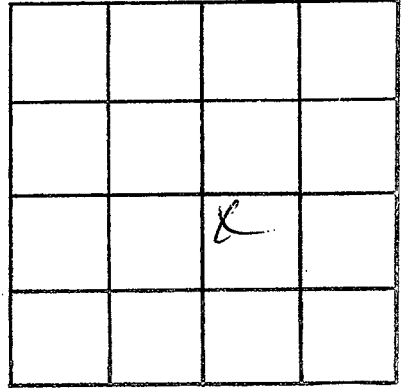

SECTION \_\_\_\_\_

Please indicate well location X.

ADDITIONAL INFORMATION

If more than one screen,  
show locations of each on sketch.