

Neshoba
 N 7
 9-67

MISSISSIPPI
 BOARD OF WATER COMMISSIONERS
 416 North State Street
 Jackson, Mississippi 39201

WATER WELL DRILLERS LOG

CODED

9-1 1967 Common Drilling Service Neshoba
 date well completed firm name county well located

LANDOWNER: Millard Brewer

description of formations encountered

from to

Route 7# Union mine

Clay	0	40
Sand	40	110
Clay	110	130
Rock Sand	130	150
Clay	150	212
Sand	212	235

(mailing address)

WELL LOCATION:

sec. 30 T. 9 N R. 10 E
 S W
3 miles N.E of Substona
 (distance) (direction) (nearest town)

WELL PURPOSE: Home
 (home, irrigation, municipal, industrial)

WELL COMPLETION DATA:

- (1) diameter (inches) 2
- (2) total depth (feet) 235
- (3) static water level (feet) 40 below above top of ground.
- (4) casing 2' (material) (depth),
 (size) if telescope see back.
- (5) screen (length) (depth to top)
 (size) (material)
- (6) pump (HP) (yield gpm)
 (type power)
- (7) electric log (yes or no)
 (organization running log)
- (8) how well bottom plugged


CODED

JUN 5 1968
 MISS. BOARD OF
 WATER COM.

DRILLERS REMARKS:

If well telescopes please sketch and show depths.

GROUND LEVEL

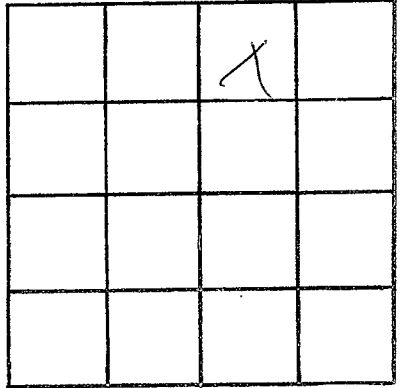

SECTION 30

Please indicate well location X.

ADDITIONAL INFORMATION

If more than one screen,
show locations of each on sketch.