

MISSISSIPPI
BOARD OF WATER COMMISSIONERS
416 North State Street
Jackson, Mississippi 39201

WATER WELL DRILLERS LOG

CODED

Neshoba
N8
5-4-71

5-4-1971 date well completed
R.R. Nicholson firm name
Neshoba county well located

LANDOWNER: David McBeath

description of formations encountered

from to

Union
Miss. RT 1
(mailing address)

Sand & Chalk	0	10
Chalk & dirt	10	17
water sand	17	26

WELL LOCATION:

sec 23 T 9 N R 10 E
7 1/2 miles west of Union
(distance) (direction) (nearest town)

WELL PURPOSE: none
(home, irrigation, municipal, industrial)

WELL COMPLETION DATA:

- diameter (inches) 4 1/4"
- total depth (feet) 26
- static water level (feet) 10 below top of ground.
- casing Gal. 21' (material) (depth)
2" (size) If telescope see back.
- screen 5' 26' (length) (depth to top)
1 1/4" (size) Steel (material)
- pump 1/2 8 (HP) (yield gpm)
Electric (type power)
- electric log (yes or no)

CODED

(organization running log)


(8) how well bottom plugged Screen

DRILLERS REMARKS:

NOV 13 1971

If well telescopes please sketch and show depths.

GROUND LEVEL

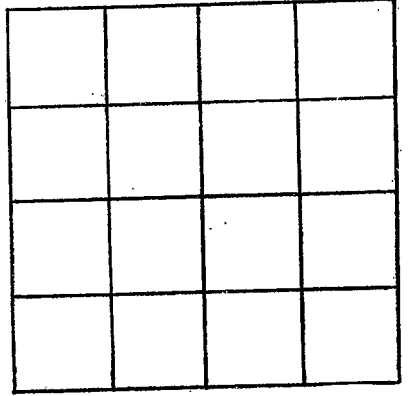

SECTION _____

Please indicate well location X.

ADDITIONAL INFORMATION

If more than one screen, show locations of each on sketch.