

TEWNN

Neshoba  
N 10  
8-20-68

MISSISSIPPI  
BOARD OF WATER COMMISSIONERS  
416 North State Street  
Jackson, Mississippi 39201

WATER WELL DRILLERS LOG

8-20 1968 B.R. Nicholson Neshoba  
date well completed firm name county well located


LANDOWNER: J.R. Ladd  
Union  
Miss. Pt 1  
(mailing address)

description of formations encountered	from	to
	<u>Clay</u>	<u>0'</u>
<u>with Clay Sand</u>	<u>25'</u>	<u>35'</u>
<u>blue dirt</u>	<u>35'</u>	<u>120'</u>
<u>rock &amp; shell</u>	<u>120'</u>	<u>135'</u>
<u>water sand</u>	<u>135'</u>	<u>160'</u>

WELL LOCATION:  
sec. 6 T 9 N R 10 E  
S W  
1 1/2 miles South of Dixon  
(distance) (direction) (nearest town)

WELL PURPOSE: home  
(home, irrigation, municipal, industrial)


- WELL COMPLETION DATA:
- (1) diameter (inches) 4 1/4"
  - (2) total depth (feet) 160'
  - (3) static water level (feet) 95' below above top of ground.
  - (4) casing gal. pipe 11 1/2"  
(material) (depth)  
2"  
(size) If telescope see back.
  - (5) screen no X  
(length) (depth to top)  
X X  
(size) (material)
  - (6) pump 1 HP. 10  
(HP) (yield gpm)  
Electric  
(type power)
  - (7) electric log no  
(yes or no)  
(organization running log)
  - (8) how well bottom plugged open

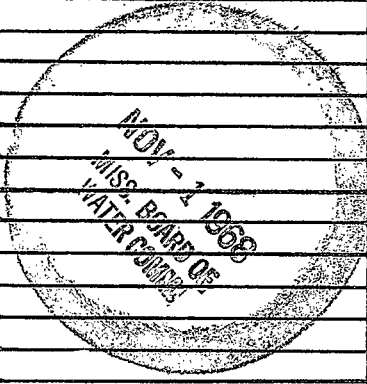

DRILLERS REMARKS:

If well telescopes please sketch and show depths.

GROUND LEVEL

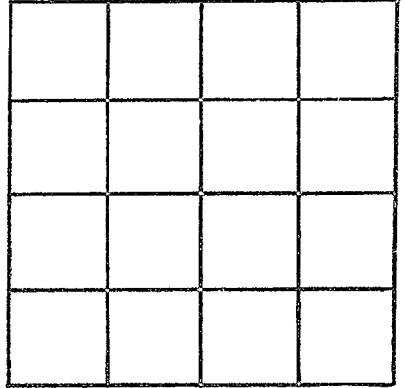

SECTION 6

Please indicate well location X.

ADDITIONAL INFORMATION

If more than one screen,  
show locations of each on sketch.