

CODED

Neshoba
N 11
1-69

MISSISSIPPI
BOARD OF WATER COMMISSIONERS
416 North State Street
Jackson, Mississippi 39201

CODED

WATER WELL DRILLERS LOG

JAN 1969 Thomas & Son Neshoba
date well completed firm name county well located

LANDOWNER: Mr. Marvin Turner
2 WALNUT GROVE
(mailing address)

description of formations encountered	from	to
<u>DIRT</u>	<u>0</u>	<u>30</u>
<u>CHALK & SAND</u>	<u>30</u>	<u>50</u>
<u>CHALK & Black DIRT</u>	<u>50</u>	<u>150</u>
<u>Rock & Shell</u>	<u>150</u>	<u>205</u>
Green Sand	205	242
<u>Green Sand</u>	<u>205</u>	<u>242</u>

WELL LOCATION:
sec. 16 T. 9 N R. 10 E
S W
3 miles SW of DIXON
(distance) (direction) (nearest town)

WELL PURPOSE:
(home, irrigation, municipal, industrial)

WELL COMPLETION DATA:

- (1) diameter (inches) 2
- (2) total depth (feet) 249
- (3) static water level (feet) 90 ^{below}/_{above} top of ground.
- (4) casing 4 1/2 (material), 199 (depth),
2" if telescope see back.
(size)
- (5) screen open (length), (depth to top)
(size) (material)
- (6) pump 1 (HP), 5 (yield gpm)
Elec (type power)
- (7) electric log NO (yes or no)
(organization running log)
- (8) how well bottom plugged

DRILLERS REMARKS:


CODED

CODED

FEB - 6 1969
MISS. Bd. OF WATER COMMISSIONERS

If well telescopes please sketch and show depths.

GROUND LEVEL

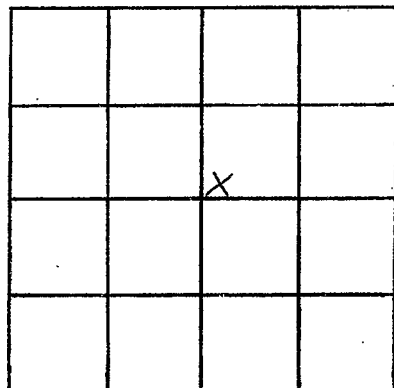

SECTION 16

Please indicate well location X.

ADDITIONAL INFORMATION

If more than one screen,
show locations of each on sketch.