

Neshoba
 N 12
 2-6-68

MISSISSIPPI
 BOARD OF WATER COMMISSIONERS
 416 North State Street
 Jackson, Mississippi 39201

CODED

WATER WELL DRILLERS LOG

2/6 1968 Conrad Drilling Service Neshoba
 date well completed firm name county well located

LANDOWNER: TOM SPARTS

Union R# 1 Miss

(mailing address)

WELL LOCATION:

sec. 12 T. 9 N R. 10 E
 S W
3 miles N.E. of Sebatopol
 (distance) (direction) (nearest town)

WELL PURPOSE: Home
 (home, irrigation, municipal, industrial)

WELL COMPLETION DATA:

- (1) diameter (inches) 2"
- (2) total depth (feet) 180
- (3) static water level (feet) 5 below above top of ground.
- (4) casing steel 178,
 (material) (depth)
 if telescope see back.
 (size)
- (5) screen iron,
 (length) (depth to top)
 (size) (material)
- (6) pump 1/2 350
 (HP) (yield gpm)
 (type power)
- (7) electric log X
 (yes or no)
 (organization running log)
- (8) how well bottom plugged

description of formations encountered	from	to
<u>Dark Clay</u>	<u>0</u>	<u>24</u>
<u>Fine Sand</u>	<u>24</u>	<u>70</u>
<u>DARK Clay</u>	<u>70</u>	<u>170</u>
<u>Sand</u>	<u>170</u>	<u>180</u>

CODED


FEB 12 1968

DRILLERS REMARKS: Open
Bottom

MISSISSIPPI
 BOARD OF
 WATER COMMISSIONERS

If well telescopes please sketch and show depths.

GROUND LEVEL

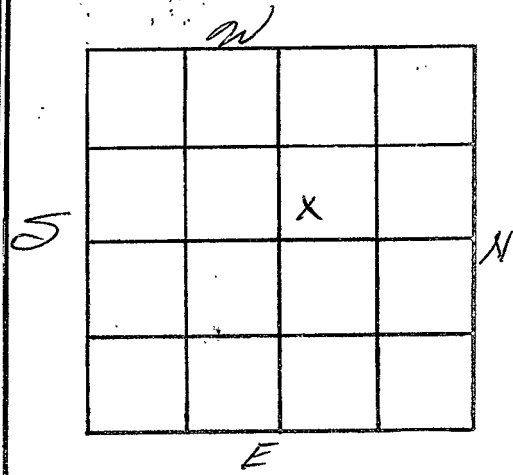

SECTION 12

Please indicate well location X.

ADDITIONAL INFORMATION

If more than one screen, show locations of each on sketch.