

Neshoba
 N. 13
 2-27-68

MISSISSIPPI
 BOARD OF WATER COMMISSIONERS
 416 North State Street
 Jackson, Mississippi 39201

CODED

WATER WELL DRILLERS LOG

2-27 1968 Common Drilling Service Neshoba
 date well completed firm name county well located

LANDOWNER: John Willis

description of formations encountered

from to

UNION #41 MISS

Dark Clay 6 140
with sand
Very Fine 140 160

(mailing address)

WELL LOCATION:

sec. 12 T. 9 N R. 10 E
 S W
3 miles N.E of Sebastopol
 (distance) (direction) (nearest town)

Dark Clay 65 74
Sand 74 86
Rocks & sand 86 130

WELL PURPOSE: HOME
 (home, irrigation, municipal, industrial)

Lilla 130 170

WELL COMPLETION DATA:

Sand Almond 170 200

(1) diameter (inches) 2"

(2) total depth (feet) _____

(3) static water level (feet) 0 below
 top of ground. above

(4) casing 5/8", 136'
 (material) (depth)

CODED

_____ if telescope see back.
 (size)

(5) screen None, _____
 (length) (depth to top)

_____ (size) _____ (material)

(6) pump 1/2, 400
 (HP) (yield gpm)

_____ (type power)

(7) electric log X
 (yes or no)

_____ (organization running log)

(8) how well bottom plugged _____

DRILLERS REMARKS: Open

Bottom to Almond Sand


Well overflows

FEB 12 1969

MISS. BD. OF
 WATER COMM.

If well telescopes please sketch and show depths.

GROUND LEVEL

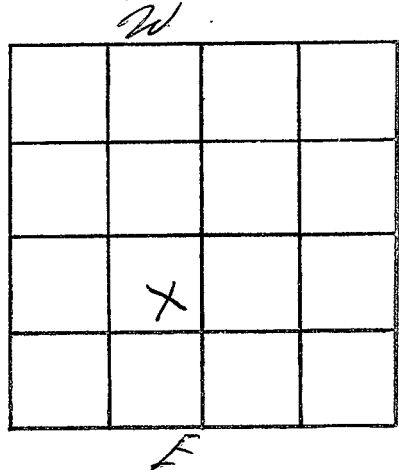

SECTION 12

Please indicate well location X.

ADDITIONAL INFORMATION

If more than one screen, show locations of each on sketch.