

Neshoba  
 N 14  
 3-4-68

MISSISSIPPI  
 BOARD OF WATER COMMISSIONERS  
 416 North State Street  
 Jackson, Mississippi 39201

CODED

WATER WELL DRILLERS LOG

3-4 1968 Common Drilling Service Neshoba  
 date well completed firm name county well located

LANDOWNER: Hubert Travis

description of formations encountered from to

Almon #1 Miss  
 (mailing address)

<u>Clay Red</u>	<u>1</u>	<u>25</u>
<u>Sand</u>	<u>25</u>	<u>40</u>
<u>Clay</u>	<u>40</u>	<u>135</u>
<u>Sand</u>	<u>135</u>	<u>190</u>
<u>Red + Dark Sand</u>	<u>190</u>	<u>200</u>
<u>Clay</u>	<u>200</u>	<u>230</u>
<u>Sand</u>	<u>230</u>	<u>248</u>

WELL LOCATION:  
 sec. 30 T. 9 N R. 10 E  
 S W  
3 miles N-E of Sebaston  
 (distance) (direction) (nearest town)

WELL PURPOSE:  
 (home, irrigation, municipal, industrial)

WELL COMPLETION DATA:

- (1) diameter (inches) 5"
- (2) total depth (feet) 250
- (3) static water level (feet) 70 below above top of ground.
- (4) casing Steel, 189  
 (material) (depth)  
 \_\_\_\_\_ if telescope see back.  
 (size)
- (5) screen None  
 (length) (depth to top)  
 \_\_\_\_\_  
 (size) (material)
- (6) pump \_\_\_\_\_  
 (HP) (yield gpm)  
 \_\_\_\_\_  
 (type power)
- (7) electric log \_\_\_\_\_  
 (yes or no)  
 \_\_\_\_\_  
 (organization running log)
- (8) how well bottom plugged \_\_\_\_\_

CODED


FEB 12 1969

MISS. DE. GE  
 WATER COMMISSIONERS

DRILLERS REMARKS: Open  
Bottom to Alluvial sand

If well telescopes please sketch and show depths.

GROUND LEVEL

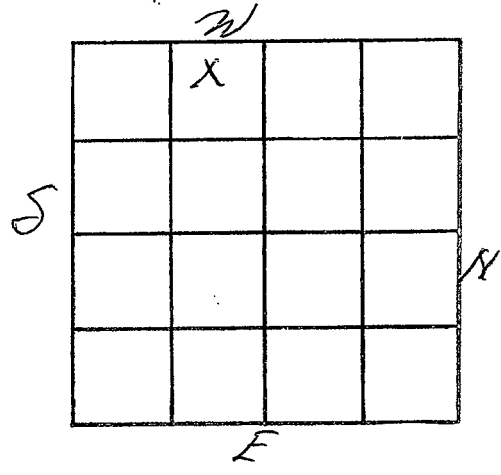

SECTION 35

Please indicate well location X.

ADDITIONAL INFORMATION

Lined area for additional information.

If more than one screen, show locations of each on sketch.