

Neshoba  
 N15  
 3-8-68

MISSISSIPPI  
 BOARD OF WATER COMMISSIONERS  
 416 North State Street  
 Jackson, Mississippi 39201

CODED

WATER WELL DRILLERS LOG

5/8 1968 Concord Drilling Neshoba  
 date well completed firm name county well located

LANDOWNER: James Haring

description of formations encountered from to

Rt 1 Genies  
 (mailing address)

|               |    |    |
|---------------|----|----|
| Clay          | 0  | 17 |
| Yellow Sand   | 17 | 20 |
| Clay          | 25 | 36 |
| Sand white    |    |    |
| Milliner Sand | 36 | 47 |

WELL LOCATION:  
 sec. 29 T 9 N R 10 E  
 S W  
 3 1/2 miles N.E. of Sebastopol  
 (distance) (direction) (nearest town)

WELL PURPOSE:  
 (home, irrigation, municipal, industrial)

WELL COMPLETION DATA:

- (1) diameter (inches) 2"
- (2) total depth (feet) 47
- (3) static water level (feet) 98 below above top of ground.
- (4) casing 5" 42 (material) (depth)  
 If telescope see back. (size)
- (5) screen 5' 42 (length) (depth to top)  
 1/2" 5/8 (size) (material)
- (6) pump 3/4 300 (HP) (yield gpm)  
 (type power)
- (7) electric log X (yes or no)  
 (organization running log)
- (8) how well bottom plugged

CODED


FFR 12 1968

MISS. BD. OF  
 WATER COMM.

DRILLERS REMARKS:

If well telescopes please sketch and show depths.

GROUND LEVEL

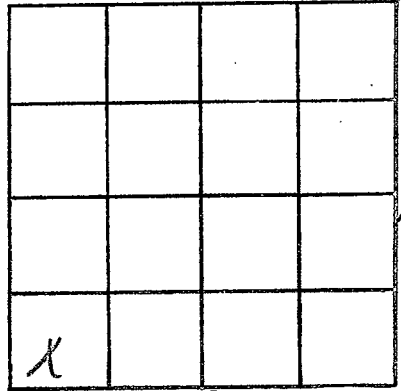

SECTION 27

Please indicate well location X.

ADDITIONAL INFORMATION

If more than one screen,  
show locations of each on sketch.