

Neshoba

N 16

7-26-68

MISSISSIPPI
 BOARD OF WATER COMMISSIONERS
 416 North State Street
 Jackson, Mississippi 39201

CODED

WATER WELL DRILLERS LOG

9-26 1968 Common Drilling Neshoba
 date well completed firm name county well located

LANDOWNER: M. J. Common

description of formations encountered	depth	
	from	to
<u>Clay</u>	<u>0</u>	<u>105</u>
<u>White Sand</u>	<u>105</u>	<u>230</u>
<u>Dark Clay</u>	<u>210</u>	<u>168</u>
<u>Sand</u>	<u>168</u>	<u>190</u>
<u>Dark Clay</u>	<u>190</u>	<u>710</u>
<u>Green Sand</u>	<u>210</u>	<u>230</u>

Union #1

Miss
 (mailing address)

WELL LOCATION:

sec. 20 T. 9 N R. 10 E
 S W
3 miles NE of Sebastopol
 (distance) (direction) (nearest town)

WELL PURPOSE: Home
 (home, irrigation, municipal, industrial)

WELL COMPLETION DATA:

(1) diameter (inches) 2 1/2"
 (2) total depth (feet) 230
 (3) static water level (feet) 40 below above
 top of ground.

(4) casing Waste, 168
 (material) (depth)

_____ If telescope see back.
 (size)

(5) screen None, _____
 (length) (depth to top)

_____ (size) _____ (material)

(6) pump 3 60
 (HP) (yield gpm)

_____ (type power)

(7) electric log _____
 (yes or no)

_____ (organization running log)

(8) how well bottom plugged _____

DRILLERS REMARKS: Open

Common


CODED

FEB 12 1969

MISS. BD. OF
WATER COMMISSIONERS

If well telescopes please sketch and show depths.

GROUND LEVEL

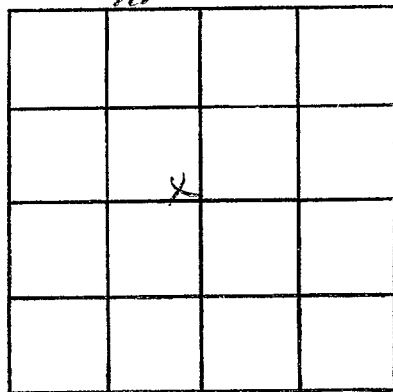

SECTION 20

Please indicate well location X.

ADDITIONAL INFORMATION

If more than one screen, show locations of each on sketch.