

coded

DeShoba  
N 18  
7-1-69

MISSISSIPPI  
BOARD OF WATER COMMISSIONERS  
416 North State Street  
Jackson, Mississippi 39201

WATER WELL DRILLERS LOG

7-1 1969 B B Nicholson Nicholson  
date well completed firm name county well located

LANDOWNER: Roman Ginter  
Union  
Miss.  
(mailing address)

description of formations encountered	from	to
	<u>Clay</u>	<u>0</u>
<u>Red dirt</u>	<u>12</u>	<u>68</u>
<u>Shell</u>	<u>68</u>	<u>105</u>
<u>rock</u>	<u>105</u>	<u>106</u>
<u>Min Sand &amp; dirt</u>	<u>106</u>	<u>115</u>
<u>Clear Sand</u>	<u>115</u>	<u>132</u>

WELL LOCATION:  
sec 13 T 9 N R 10 E  
S W  
11 miles West of Union  
(distance) (direction) (nearest town)

WELL PURPOSE: home  
(home, irrigation, municipal, industrial)


- WELL COMPLETION DATA:
- (1) diameter (inches) 4 1/4
  - (2) total depth (feet) 132
  - (3) static water level (feet) 20 below above top of ground.
  - (4) casing Galv. P 106  
(material) (depth)
  - (size) if telescope see back.
  - (5) screen ✓ / ✓  
(length) (depth to top)
  - (size) (material)
  - (6) pump 1/2 / 8  
(HP) (yield gpm)
  - Elect.  
(type power)
  - (7) electric log NO  
(yes or no)
  - (organization running log)
  - (8) how well bottom plugged open

DRILLERS REMARKS:

SEP - 3 1969  
MISS. B. OF WATER COMMISSIONERS

If well telescopes please sketch and show depths.

GROUND LEVEL

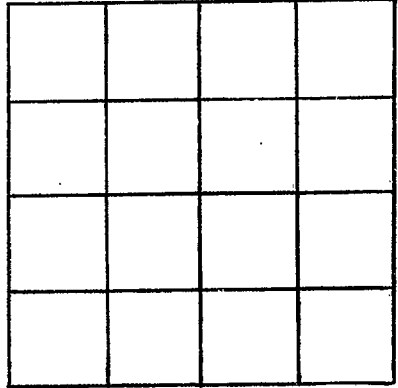

SECTION 13

Please indicate well location X.

ADDITIONAL INFORMATION

If more than one screen, show locations of each on sketch.