

coded

Neshoba
N 19
7-22-69

MISSISSIPPI
BOARD OF WATER COMMISSIONERS
416 North State Street
Jackson, Mississippi 39201

WATER WELL DRILLERS LOG

7-22 1969 RR Nicholson Neshoba
date well completed firm name county well located

LANDOWNER: Fred Watkins
Shila Miss.

(mailing address)

description of formations encountered	from	to
<u>Chalk & dirt</u>	<u>0</u>	<u>35</u>
<u>Wet Sand & dirt</u>	<u>35</u>	<u>90</u>
<u>Blue dirt</u>	<u>90</u>	<u>190</u>
<u>Water Sand</u>	<u>190</u>	<u>212</u>

WELL LOCATION:
sec. 9 T. 9 N R. 10 E
17 miles West of Shila
(distance) (direction) (nearest town)

WELL PURPOSE: home
(home, irrigation, municipal, industrial)

- WELL COMPLETION DATA:
- (1) diameter (inches) 4 1/4
 - (2) total depth (feet) 212
 - (3) static water level (feet) 75 below above top of ground.
 - (4) casing Galv P 207
(material) (depth)
2" if telescope see back.
(size)
 - (5) screen 5" 212
(length) (depth to top)
1/4" Steel
(size) (material)
 - (6) pump 1 10
(HP) (yield gpm)
Elect
(type power)
 - (7) electric log no
(yes or no)
- (organization running log)
- (8) how well bottom plugged fair


SEP - 9 1969

MISS. BD. OF
WATER COMMISSIONERS

DRILLERS REMARKS:

If well telescopes please sketch and show depths.

GROUND LEVEL

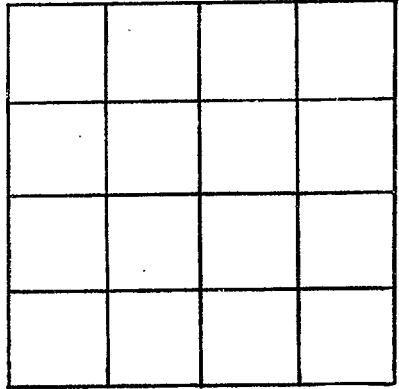

SECTION 9

Please indicate well location X.

ADDITIONAL INFORMATION

If more than one screen, show locations of each on sketch.