

Neshoba
 N 20
 9-19-69

MISSISSIPPI
 BOARD OF WATER COMMISSIONERS
 416 North State Street
 Jackson, Mississippi 39201

CODED

CODED

WATER WELL DRILLERS LOG

9-19 1969 R B Nicholson Neshoba
 date well completed firm name county well located

| LANDOWNER: <u>J E Watson</u> <u>Union</u> <u>Miss</u> (mailing address) | description of formations encountered | from | to |
|--|---------------------------------------|-------------------------|------------|
| | | <u>Chalky Blue dirt</u> | <u>0</u> |
| | <u>Shell rock</u> | <u>30</u> | <u>38</u> |
| | <u>Blue dirt</u> | <u>30</u> | <u>135</u> |
| | <u>Water Sand</u> | <u>135</u> | <u>160</u> |

WELL LOCATION:
 sec. 12 T. 9 N R. 10 E
16 miles ^S South of ^W Shila
 (distance) (direction) (nearest town)

WELL PURPOSE: home
 (home, irrigation, municipal, industrial)

- WELL COMPLETION DATA:
- diameter (inches) 4 1/4
 - total depth (feet) 160
 - static water level (feet) 20 below top of ground.
 - casing Galv. P. 63
 (material) (depth)
7" If telescope see back.
 (size)
 - screen ✓ 160
 (length) (depth to top)
✓
 (size) (material)
 - pump 1 12
 (HP) (yield gpm)
Elect.
 (type power)
 - electric log ✓
 (yes or no)
- (organization running log)
- (8) how well bottom plugged open


JAN 21 1970

MISS. DD. OF
 WATER COMMISSIONERS

DRILLERS REMARKS:

If well telescopes please sketch and show depths.

GROUND LEVEL

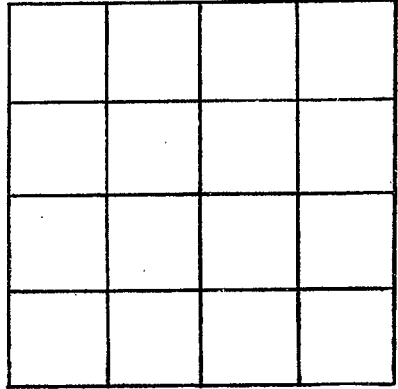

SECTION 12

Please indicate well location X.

ADDITIONAL INFORMATION

If more than one screen, show locations of each on sketch.