

Neshoba
N 21
10-18-69
10-18
 date well completed

MISSISSIPPI
 BOARD OF WATER COMMISSIONERS
 416 North State Street
 Jackson, Mississippi 39201

CODED
 CODED

WATER WELL DRILLERS LOG

1969 RR Nicholson Neshoba
 firm name county well located

LANDOWNER: Mrs. Mandy Nicholson
Union
Miss.
 (mailing address)

| description of formations encountered | from | to |
|---------------------------------------|-------------|------------|
| | <u>Clay</u> | <u>0</u> |
| <u>blue dirt</u> | <u>15</u> | <u>102</u> |
| <u>rock</u> | <u>102</u> | <u>104</u> |
| <u>blue dirt</u> | <u>104</u> | <u>135</u> |
| <u>water sand</u> | <u>135</u> | <u>150</u> |

WELL LOCATION:
 sec 16 T 9 N R 10 E
7 miles N of Union
 (distance) (direction) (nearest town)

WELL PURPOSE:
 (home, irrigation, municipal, industrial)

- WELL COMPLETION DATA:
- diameter (inches) 4 1/4
 - total depth (feet) 150
 - static water level (feet) 75 below above top of ground.
 - casing galv. p. 145
 (material) (depth)
2 if telescope see back.
 (size)
 - screen 5' 150
 (length) (depth to top)
1 1/4" steel
 (size) (material)
 - pump 1 10
 (HP) (yield gpm)
elect.
 (type power)
 - electric log _____
 (yes or no)
 - _____ (organization running log)
 - how well bottom plugged _____


JAN 21 1970

MISS. BD. OF
 WATER CONTROL

DRILLERS REMARKS:

If well telescopes please sketch and show depths.

GROUND LEVEL

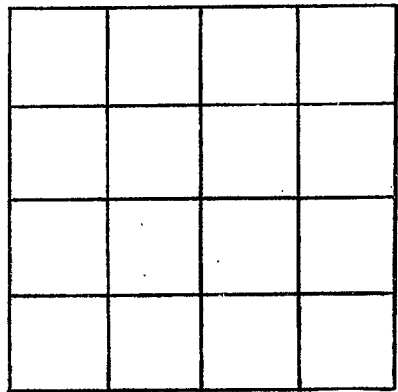

SECTION 16

Please indicate well location X.

ADDITIONAL INFORMATION

A series of horizontal lines for writing additional information, starting below the 'ADDITIONAL INFORMATION' header and extending to the bottom of the page.

If more than one screen, show locations of each on sketch.