

Neshoba
 N22,
 12-29-69

MISSISSIPPI
 BOARD OF WATER COMMISSIONERS
 416 North State Street
 Jackson, Mississippi 39201

CODED
 CODED

WATER WELL DRILLERS LOG

12-29 1969 BB Nicholson Neshoba
 date well completed / firm name county well located


LANDOWNER: <u>Joe Carter</u> <u>Union</u> <u>Miss</u> (mailing address)	description of formations encountered	from to	
	<u>Chalk & dirt</u>	<u>0</u>	<u>19</u>
	<u>Mud part of sand</u>	<u>19</u>	<u>35</u>
	<u>Water sand</u>	<u>35</u>	<u>49</u>
WELL LOCATION: sec. <u>21</u> T <u>9</u> N R <u>10</u> E S W <u>9</u> miles <u>W</u> of <u>Union</u> (distance) (direction) (nearest town)			
WELL PURPOSE: <u>Home</u> (home, irrigation, municipal, industrial)			
WELL COMPLETION DATA:			
(1) diameter (inches) <u>4 1/4</u>			
(2) total depth (feet) <u>49</u>			
(3) static water level (feet) <u>26</u> below above top of ground.			
(4) casing <u>galv. p.</u> <u>44</u> (material) (depth) <u>2"</u> (size) if telescope see back.			
(5) screen <u>5-</u> <u>49</u> (length) (depth to top) <u>1/4</u> <u>Steel</u> (size) (material)			
(6) pump <u>1/2</u> <u>8</u> (HP) (yield gpm) <u>Elect.</u> (type power)			
(7) electric log <u>no</u> (yes or no)			
(organization running log)			
(8) how well bottom plugged _____			
DRILLERS REMARKS:			

JAN 21 1970

MISS. BD. OF
 WATER COMM.

If well telescopes please sketch and show depths.

GROUND LEVEL

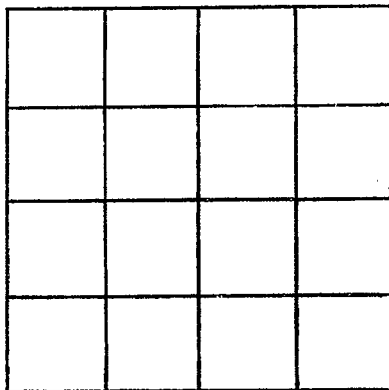

SECTION 21

Please indicate well location X.

ADDITIONAL INFORMATION

If more than one screen, show locations of each on sketch.