

Neshoba

N 30

8-15-72

MISSISSIPPI BOARD OF WATER COMMISSIONERS
416 North State Street
Jackson, Mississippi 39201

CODED

WATER WELL DRILLERS LOG

8-15-72
date well completed

1972 *Cement Drilling Neshoba*
firm name county well located

LANDOWNER: *Reba Lopez*

Genison R & L Min

(mailing address)

WELL LOCATION:

sec. 13 T 9 N R 10 E

3 miles N-E of Sebastopol
(distance) (direction) (nearest town)

WELL PURPOSE:
(home, irrigation, municipal, industrial)

WELL COMPLETION DATA:

- (1) diameter (inches) 2"
- (2) total depth (feet) 290
- (3) static water level (feet) 70 below above top of ground.

(4) casing Steel 189
(material) (depth)

(size) if telescope see back.

(5) screen (length) (depth to top)

(size) (material)

(6) pump 1 1/2 5
(HP) (yield gpm)

E
(type power)

(7) electric log No
(yes or no)

(organization running log)

(8) how well bottom plugged

description of formations encountered

from to

Clay 0 43

Sand 43 48

Clay 48 84

Sand 84 139

Rock + shell 139 141

Clay 141 166

Sand 166 218

Clay 218 235

Clay 235 240

Sand 240 290

CODED

SEP 28 1972


MISS. RD. & WATER COM.

DRILLERS REMARKS:

open bottom

If well telescopes please sketch and show depths.

GROUND LEVEL

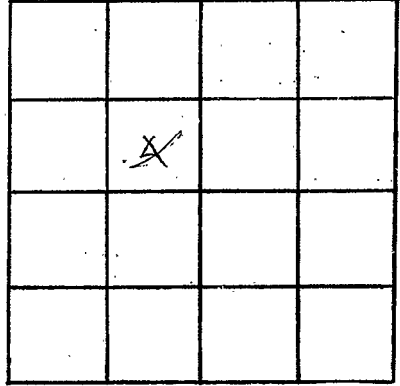

SECTION 13

Please indicate well location X.

ADDITIONAL INFORMATION

If more than one screen, show locations of each on sketch.