

Neshoba
N 32
12-27-72

MISSISSIPPI
 BOARD OF WATER COMMISSIONERS
 416 North State Street
 Jackson, Mississippi 39201

CODED

WATER WELL DRILLERS LOG

12/27/72 1972 F. D. Comoy UFS Hobart
 date well completed firm name county well located

LANDOWNER: Ever R Moore

description of formations encountered	from	to
<u>Red Clay</u>	<u>0</u>	<u>15"</u>
<u>Clay</u>	<u>15"</u>	<u>15"</u>
<u>Sand Core</u>	<u>45"</u>	<u>63"</u>

(mailing address)

WELL LOCATION:

sec. 19 9 N 10 E
3 miles S of Fossil Hill
 (distance) (direction) (nearest town)

WELL PURPOSE:

(home, irrigation, municipal, industrial)

WELL COMPLETION DATA:

- (1) diameter (inches) 2"
 - (2) total depth (feet) 63
 - (3) static water level (feet) 30 below above top of ground.
 - (4) casing 2 p.v.c. 57'
 (material) (depth)
2" if telescope see back.
 (size)
 - (5) screen 105 5.5-6'63
 (length) (depth to top)
1 1/2 5.5
 (size) (material)
 - (6) pump 1/2 110
 (HP) (yield gpm)
C. Les.
 (type power)
 - (7) electric log NO
 (yes or no)
- (organization running log)

CODED


(8) how well bottom plugged org.

JAN 3 1972

DRILLERS REMARKS:

If well telescopes please sketch and show depths.

GROUND LEVEL

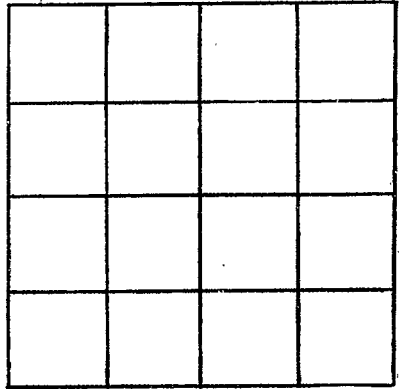

SECTION _____

Please indicate well location X.

ADDITIONAL INFORMATION

If more than one screen, show locations of each on sketch.