

CODED

MISSISSIPPI
BOARD OF WATER COMMISSIONERS
416 North State Street
Jackson, Mississippi 39201

WATER WELL DRILLERS LOG

Neshoba
N 33
1-73

JAN 1973 Thomas & Son Neshoba
date well completed firm name county well located

LANDOWNER: Truman Collier
Rt 9
Philadelphia, Miss.
(mailing address)

description of formations encountered	from	to
<u>Red Clay</u>	<u>0</u>	<u>10</u>
<u>Red Sand</u>	<u>10</u>	<u>30</u>
<u>SAND w/ CHALK</u>	<u>30</u>	<u>50</u>
<u>White Sand</u>	<u>50</u>	<u>68</u>

WELL LOCATION:
sec. 6 T. 9 N. R. 10 E.
5 miles SW of Dixon
(distance) (direction) (nearest town)

WELL PURPOSE:
(home, irrigation, municipal, industrial)
Home

- WELL COMPLETION DATA:
- (1) diameter (inches) 2
 - (2) total depth (feet) 68
 - (3) static water level (feet) 50 ^{below} above top of ground.
 - (4) casing PVC, 63,
(material) (depth)
2
(size) if telescope see back.
 - (5) screen 5, 63
(length) (depth to top)
2" 8.8/ot PVC
(size) (material)
 - (6) pump 3/4 6
(HP) (yield gpm)
Elec
(type power)
 - (7) electric log NO
(yes or no)
 - (organization running log)
 - (8) how well bottom plugged Perit


CODED

DRILLERS REMARKS:

MAR 13 1973

If well telescopes please sketch and show depths.

GROUND LEVEL

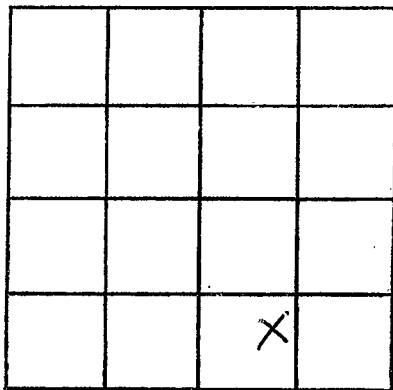

SECTION 6

Please indicate well location X.

ADDITIONAL INFORMATION

If more than one screen, show locations of each on sketch.