

NESHOBA
N 34
12-18-73

MISSISSIPPI
 BOARD OF WATER COMMISSIONERS
 416 North State Street
 Jackson, Mississippi 39201

CODED

WATER WELL DRILLERS LOG

12-18-73 19 F.D. Comoy NESHOBA
 date well completed firm name county well located

LANDOWNER: <u>Bob Crownshaw</u> <u>Philau. Rt # 7</u> (mailing address)	description of formations encountered	from	to
		<u>Red clay</u>	<u>0</u>
	<u>Sand</u>	<u>20</u>	<u>60</u>
	<u>Coarse Sand</u>	<u>60</u>	<u>90</u>

WELL LOCATION:
 sec. 1809 N R10 E
1 miles S of Lowville Hill
 (distance) (direction) (nearest town)

WELL PURPOSE:
 home irrigation, municipal, industrial

- WELL COMPLETION DATA:
- (1) diameter (inches) 2"
- (2) total depth (feet) 80
- (3) static water level (feet) 4.5 below above top of ground.
- (4) casing 2" p.v.c. 76'
 (material) (depth)
2"
 (size) if telescope see back.
- (5) screen 2" p.v.c. 76'
 (length) (depth to top)
2" p.v.c. 61'
 (size) (material)
- (6) pump 110
 (HP) (yield gpm)
Edco.
 (type power)
- (7) electric log NO
 (yes or no)
2" Cap.
 (organization/running log)
- (8) how well bottom plugged _____

CODED


DEC 20 1973

DRILLERS REMARKS: _____

MISS. BO. OF
 WATER COMMISSIONERS

If well telescopes please sketch and show depths.

GROUND LEVEL

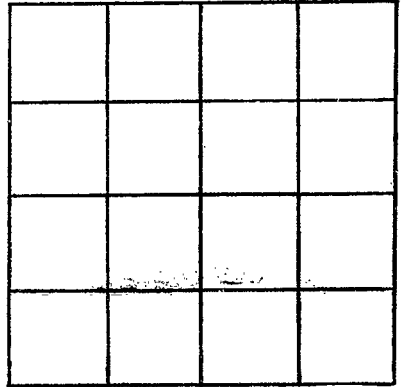

SECTION _____

Please indicate well location X.

ADDITIONAL INFORMATION

If more than one screen,
show locations of each on sketch.