

NESHOKA

N35

8/74

MISSISSIPPI BOARD OF WATER COMMISSIONERS  
416 North State Street  
Jackson, Mississippi 39201

WATER WELL DRILLERS LOG

CODED

August 1974  
date well completed

Thomasson  
firm name

Neshoba  
county well located

LANDOWNER: W. E. Thomas

Rt-9

description of formations encountered

from to

Red Clay  
SAND

0 2  
2 42

Black dirt & shells SAND

42 69

Little Rock

69

Black dirt

69 128

Rock & shell

128 165

Green Sand

165 185

Philadelphia, Miss  
(mailing address)

WELL LOCATION:

sec. 6 T-9 N R-10 E

2 1/2 miles E of Madden  
(distance) (direction) (nearest town)

WELL PURPOSE:  
(home, irrigation, municipal, industrial)

WELL COMPLETION DATA:

- (1) diameter (inches) 2
- (2) total depth (feet) 185
- (3) static water level (feet) 63 below top of ground.

(4) casing PVC 140  
(material) (depth)

2 If telescope see back.  
(size)

(5) screen Open  
(length) (depth to top)

(size) (material)

(6) pump 1 7  
(HP) (yield gpm)

elec.  
(type power)

(7) electric log NO  
(yes or no)

(organization running log)

(8) how well bottom plugged open

DRILLERS REMARKS:


CODED

RECEIVED  
NOV 13 1974

MISS. BD. OF WATER COMM

If well telescopes please sketch and show depths.

GROUND LEVEL

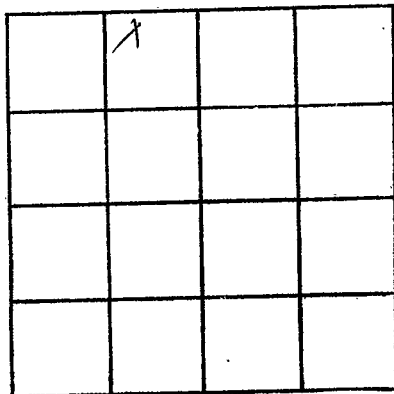

SECTION 6

Please indicate well location X.

ADDITIONAL INFORMATION

If more than one screen, show locations of each on sketch.