	j State W	Vell Report	·*			
County: Neshoba	Part 1 – Driller's Log		For Office Use Only:			
Permit #:	Mississippi Department of Environmental Quality		Aquifer:			
Driller: Thomas Orilling	Office of Land and Water Resources P.O. Box 2309		Well #: N 49			
	Jackson, MS 39225		L. S. Elevation:			
Date drilling completed: 1-21-16	(601)961- 5210 (601)961- 5228 (fax)					
		E-log #:				
State Law requires that this report be prepared by the license holder responsible for the work and filed with the Department at the above address within 30 days of completion of drilling of the well or borehole.						
information on Well C	)wnęr	Well or Bo	rehole Location			
(Landowner if borehole is not for a water well)		Latitude: 32 ° 36 '5./2" Longitude: 89 ° /4 ' Zz. S6				
Owner Name Terry Le	Terry Le #4		Method of Lat/Long (circle one): Conventional Survey,			
Mailing Address: 1097 Road	109		•			
			USGS quad, Hand-held GPS, Survey-grade GPS			
UNION MS 39365 City State Zip Code		<u>50 % NE% Sec 26 Twn 9N Rng/0 E</u>				
	City State Zip Code Distance Direction		Nearest Town			
City State Zip Code Distance Direction  Telephone No. (7b) 380 - 1936  Miles NF			of Sobastapo)			
Well / Borehole Data						
Date drilling started: 1-21-16 Date drilling completed: 1-21:16 Hole depth: 7 4 0 Hole diameters 4"						
Location of the source of any surface water used for drilling:  Method of dosing and volume of Chlorine used in drilling and development:						
Logs run (circle all applicable): Log log un Electric Gamma Ray Density Sonic Neutron Other:  Name of organization running log(s):						
Purpose of borehole (check one): Water Well  Geotechnical/Geological Investigation Ground Source Heat Pump						
Seismic Survey Other (describe)						
If drilling is not related to water well construction, skip the remainder of this block						
Purpose of Well (check one): Home Industrial Public Supply Irrigation Fish Culture Other:						
If a flowing well, method of flow regulation: Valve Other (describe)						
Static Water Level: 80 feet above or below (circle one) land surface Date measured: 1-21-16						
Method of Measurement (circle one) steel tape electric tape air line, other:						
Well dcpth: 240 Well grouted to a dcpth of 10 feet Type of grout (circle one): Neat Cement Bentonie Mix						
Casing length: 2 15 feet Casing diameter: 4 inches Type of casing: PUC						
Screen length: Z5 feet Screen diameter: 4 inches Type of screen: PUC						
Screen slot size: 010 inches	Setting depth: From	2/5 feet to 24	ect feet			
Type of completion (circle all applicable): Gravel packed Underreamed Telescoped Open hole Natural Development						
Other (describe):						
Top of lap pipe or reduction in casing:feet. If telescoped or more than one screen, describe on next page						
Form: OLIMP SWP 14 (04/09)						

## The sketch below only required for water wells


If well telescopes, show depths on sketch.

Ground Level.....

Description of formations encountered must be provided for all wells and boreholes, unless specifically exempted by regulations

Description of Formations Encountered	From (depth)	To (depth)
	Ground Level	T
Red SAND & DITT	0	20
White SANN	20	*(
SAND Some Jan	25	125
lock	115	122
Gray Clay	12.2	199
Rock	180	195
Green Sand & Clay	185	200
Gray SANA	200	2.20
TE G-AL SAIL	220	2 10
	<u> </u>	

If more than one screen, show location of each on sketch

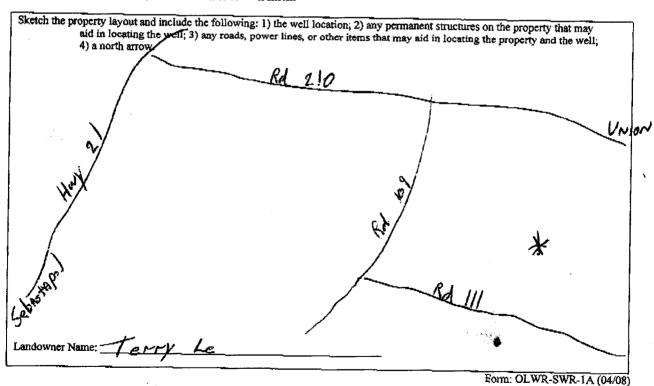

I certify that the well/borehole was drilled, constructed, and completed in accordance with all applicable requirements of the Mississippi Department of Environmental Quality and the Mississippi Department of Health regulations, if applicable, and state

Print Name of Responsible Licensee and License No.

1-21-16

Date

Signature of Licensee

STATE WELL REPORT					
County: Neshaba		Part 2			
	Pump Installer's Completion Report		For Office Use Only:		
Permit #:	Mississippi Department of Environmental Quality Office of Land and Water Resources		Aquifer:		
Date completed; <u>7-10-16</u>	P.O. Box 2309  Jackson, MS 39225		Well #: N49		
Copy information from block on Part 1	(601)961-5210 (601)961-5228 (fax)		Elevation:		
This part of the report must be completed by a licensed water well contractor or a licensed pump installer. A copy of Part 1 of the					
report must be attached and both parts filed with the Department at the above address within 30 days of well completion.  Well Owner Information					
		Well	Location		
Owner Name: Levry Le		Latitude: 32° 36 5 /2"	Longitude: 89°/4′22.56°		
Mailing Address: 10910 Ro	pad [0]	Method of Lat/Long (check one	): Conventional Survey,		
January MC	29766	USGS quad, Hand-held G	PS Survey-grade GPS		
City MS 39365  City State Zip Code		¼¼ Sec <u>26</u>	T 9N R 10E		
Telephone No. (270) 380 - 1936		Distance Direction	Nearest Town		
		Miles of	Sebastabol		
Pump Type Circle one		Powe	r Type		
Ain I io		Circ	e one		
<b> </b>	ubmersible)	Diesel Engine Gasoline I	Engine Natural Gas		
	urbine	Efectric Motor Hand	Tractor PTO		
	lowing Well		eify):		
Other (specify):		Horse Power Rating of Motor:			
Date Pump Installed: Z-/0-/6		Setting Depth: /50fcet			
Rated Pump Capacity: 55 Ga	llons Per Minute	Number of Stages: 15.			
Pump Test Data					
Date Well Tested: 2-10-16		Method of Measuring Water Level Circle one			
Static Water Level (A): 80 Feet Below Land Surface		Air Line Electric Measuring	ng Line Steel Tape		
Pumping Water Level (B): 120 Feet Below Land Surface		Other (specify):			
Drawdown [(B) ~ (A)]:Feet Below Land Surface		For flowing well, measured shut in	head		
Test Pumping Rate:Gallons Per Minute		Well yieldedGF			
Duration of Pump Test (minimum 4 hours):hours		fcet after			
***					
I HEREBY CERTIFY that the above statements are true to the best of my knowledge.					
Print Name of Pump Jeets Hay and Visconia					
Print Name of Pump Installer and License No. (if applicable)  Signature of Pump Installer					
Form: OLWR-SWR-1B (04/08)					