

NESHOBA
 N 200
 2-4-77

MISSISSIPPI
 BOARD OF WATER COMMISSIONERS
 416 North State Street
 137 Jackson, Mississippi 39201

WATER WELL DRILLERS LOG

19 Comand Drilling Service Neshoba
 firm name county well located

date well completed
2-4-77

LANDOWNER: Morine Price
R 5 Philadelphia
Miss
 (mailing address)

description of formations encountered	from	to
<u>Clay</u>	<u>0</u>	<u>20</u>
<u>Sand</u>	<u>20</u>	<u>90</u>
<u>Clay</u>	<u>90</u>	<u>150</u>
<u>Rock ledges + Sand</u>	<u>150</u>	<u>165</u>
<u>Sand</u>	<u>165</u>	<u>200</u>

WELL LOCATION:
 sec. 18 T. 9 S. R. 10 E.
5 miles N.E. of Substant
 (distance) (direction) (nearest town)

WELL PURPOSE: Dom
 (home, irrigation, municipal, industrial)

- WELL COMPLETION DATA:
- diameter (inches) 2"
 - total depth (feet) 280
 - static water level (feet) 40 above top of ground.
 - casing Steel 147
 (material) (depth)
 (size) if telescope see back.
 - screen None
 (length) (depth to top)
 (size) (material)
 - pump 1 7
 (HP) (yield gpm)
E
 (type power)
 - electric log NO
 (yes or no)
 (organization running log)
 - how well bottom plugged


DRILLERS REMARKS:
Open Bottom

RECEIVED
 MAY 9 - 1977

MISS. BD. OF WATER COMMISSIONERS

If well telescopes please sketch and show depths.

GROUND LEVEL

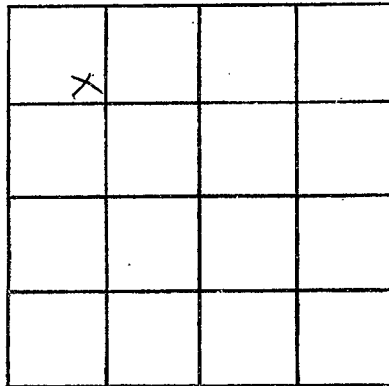

SECTION _____

Please indicate well location X.

ADDITIONAL INFORMATION

If more than one screen, show locations of each on sketch.