

NESHOBA

N 203

2/21/78

MISSISSIPPI  
 BOARD OF WATER COMMISSIONERS  
 416 North State Street  
 Jackson, Mississippi 39201

WATER WELL DRILLERS LOG

2-21-78, McDonald & Will Neshoba  
 date well completed firm name county well located

LANDOWNER:

Frank Hillman

Rt #1 Union

(mailing address)

description of formations encountered

from

to

clay & sand

0

20

clay, silt shale & sand

30

40

sandy shale

40

65

shale

65

112

Rock & shells

112

140

WELL LOCATION:

sec. 28 T 9 N R 10 E  
6 miles N of Charleston  
 (distance) (direction) (nearest town)

WELL PURPOSE:

home (home, irrigation, municipal, industrial)

green sand

140

150

WELL COMPLETION DATA:

- (1) diameter (inches) 4"
- (2) total depth (feet) 200'
- (3) static water level (feet) 14' below above top of ground.
- (4) casing PVC 100' (material) (depth)  
4" (size) If telescope see back.
- (5) screen \_\_\_\_\_ (length) \_\_\_\_\_ (depth to top)  
\_\_\_\_\_  
(size) (material)
- (6) pump 3/4 60-80 (HP) (yield gpm)  
E (type power)
- (7) electric log \_\_\_\_\_ (yes or no)  
\_\_\_\_\_  
(organization running log)
- (8) how well bottom plugged green

shale

150

160

Rock, shale & sand

160

200


RECEIVED  
 FEB 27 1978

DRILLERS REMARKS:

MISS. BO. OF WATER COMM

If well telescopes please sketch and show depths.

GROUND LEVEL

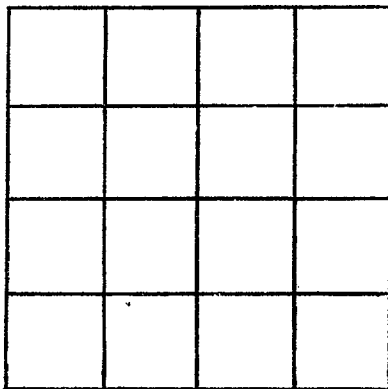

SECTION \_\_\_\_\_

Please indicate well location X.

ADDITIONAL INFORMATION

If more than one screen,  
show locations of each on sketch.