

N 2004

WATER WELL DRILLERS LOG

Date: Sept. 1978, Driller: Thomas & Son County, Neshoba

(When well drilled)

(Name)

(Where well is located)

(1) Owner of Land: D. Carter Rt. 9 Phila. Ms.

(Name)

(Address)

Description & Color of Materials Sand, Clay, Red Clay, Shell, etc.

Thick-ness Feet

Depth Feet

Red CLAY 0 5 Red SAND 5 20 All coarse SAND 20 69

(2) Location: NW 1/4, NE 1/4, Sec. 9 T.9R.10 3 miles SW of DIXON

(distance)

(direction)

(Nearest Town)

(3) Topography: (Hilly) (Flat) (Level)

(4) Purpose of Well: (Domestic Irrigation Municipal, Industrial, Other)

Information upon completion of well:

- (1) Diameter 2 inches. (2) Total Depth 69 feet. (3) Water Level 50 feet below top of ground. (4) Cased to 64, Size 2 (5) Screen: Size 2 1/2" Length 5' PC (6) Were any formations sealed against pollution? yes, [check] no.

If YES depth of formation

Why

Drillers Remarks: Point


Yield in gpm: 5

Size pump: 1/2

Type power: elec.

RECEIVED OCT 17 1978

MISS. BD. OF WATER COMM

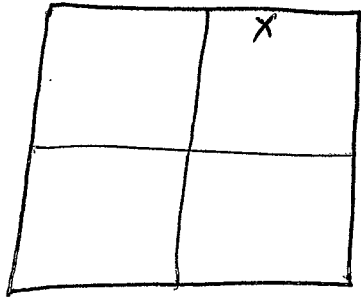

9